


The above is a correct Record Plat of a Survey made by me Oct. 15, 1867, on Sec. 15, La Prairie.

S.D. Locke, County Surveyor in & for Rock Co. Wis.

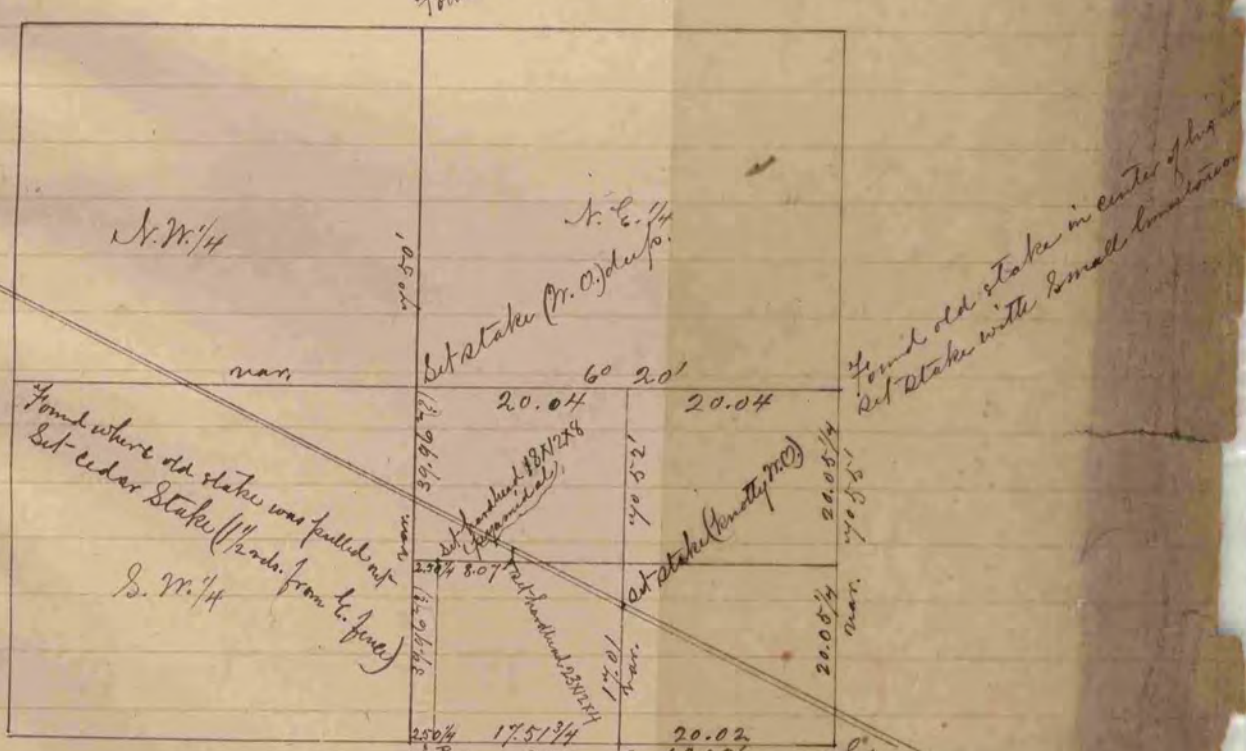

The above is a correct Record Plat of a Survey made by me Oct. 22, 1867, on Sec. 22, Harmony S.D. Locke County Surveyor in & for Rock Co. Wis.