


Br. 014 S. 44 E. 29

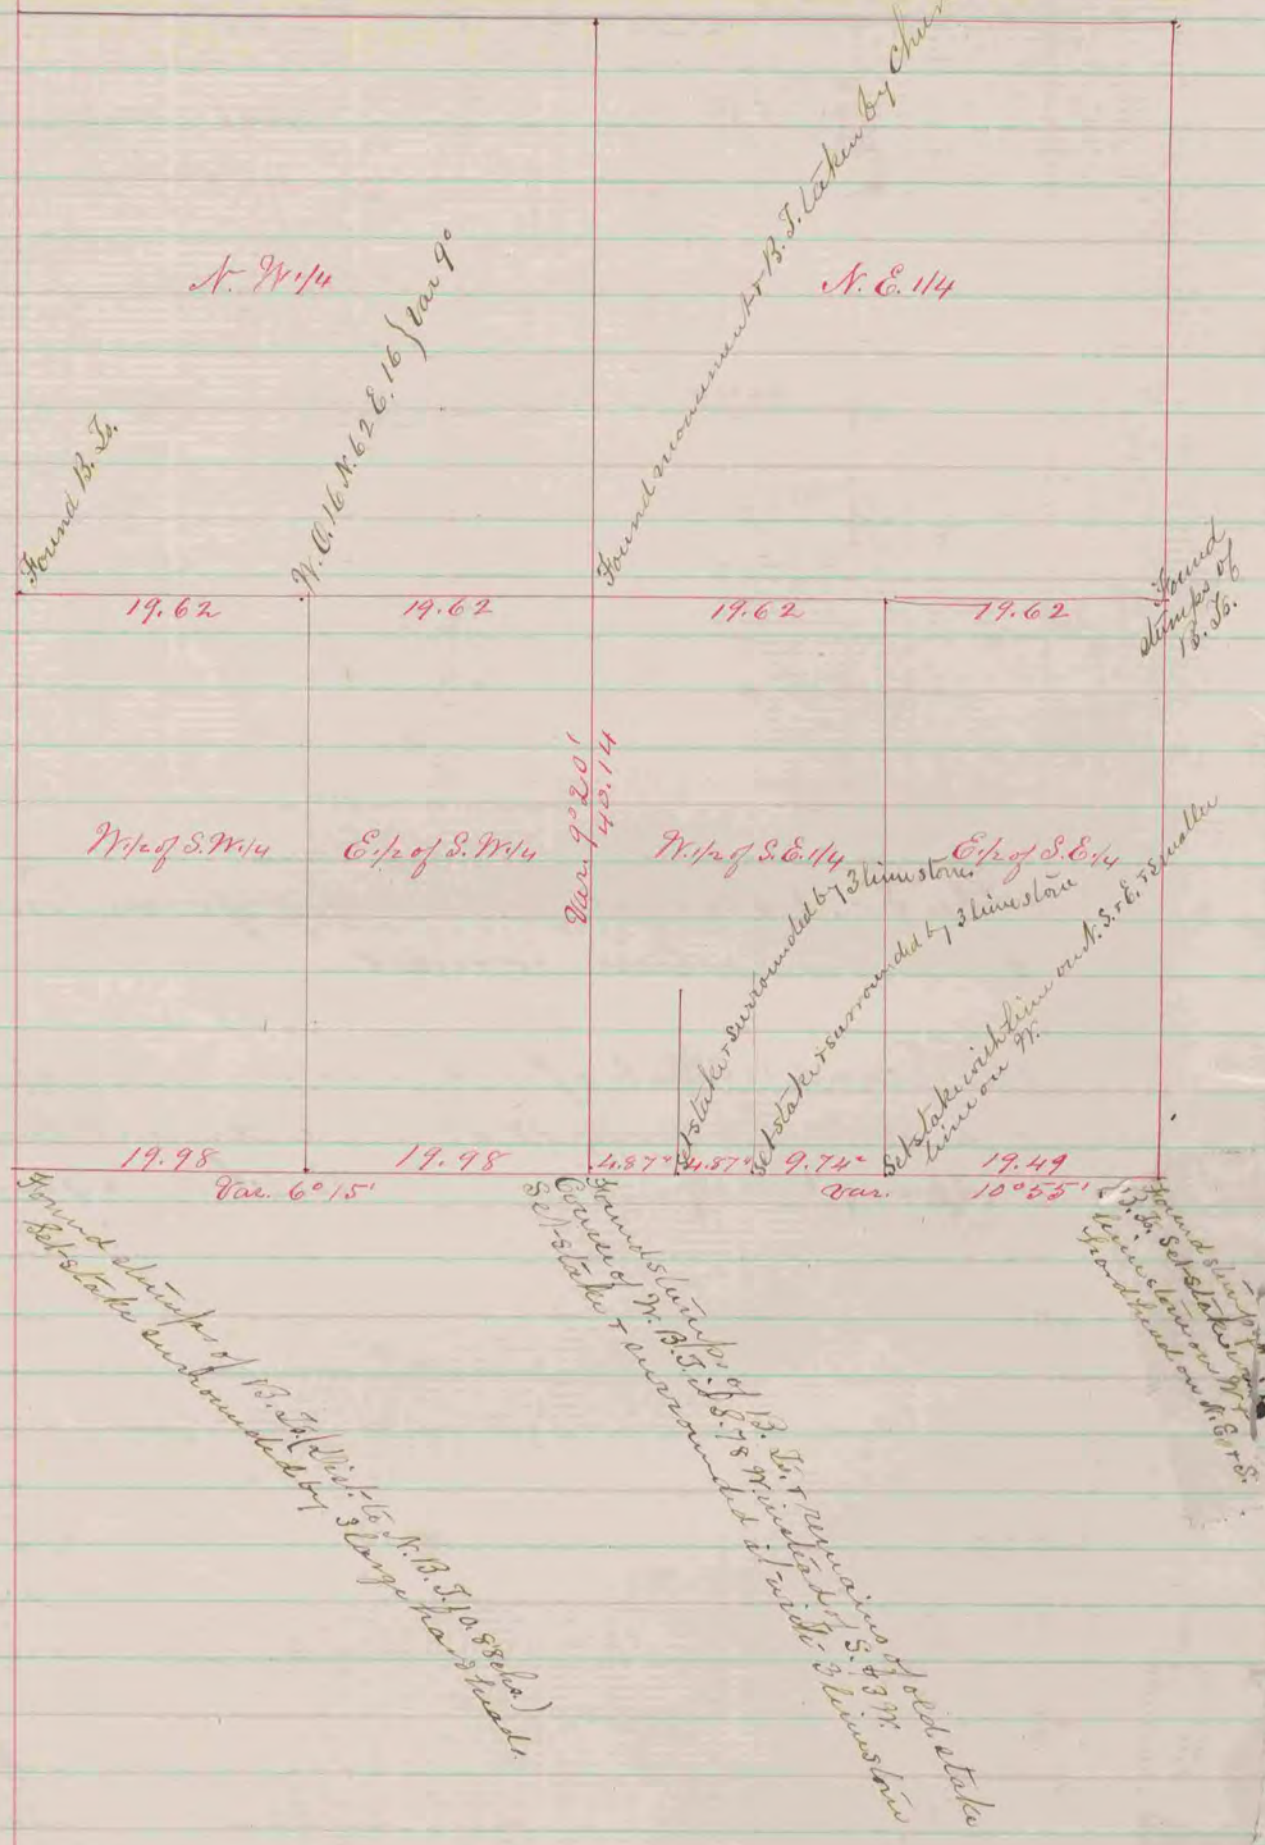

The above is a correct Record & Plat of a Survey  
 made by me May 1-2 1866, on Sec. 15 Spring Valley  
 S. W. Locke  
 Co. Surveyor