


A Record & Plat of a Survey made by me June 17/85 on Sec. 29
Town of Bradford

S. D. Locke County Surveyor

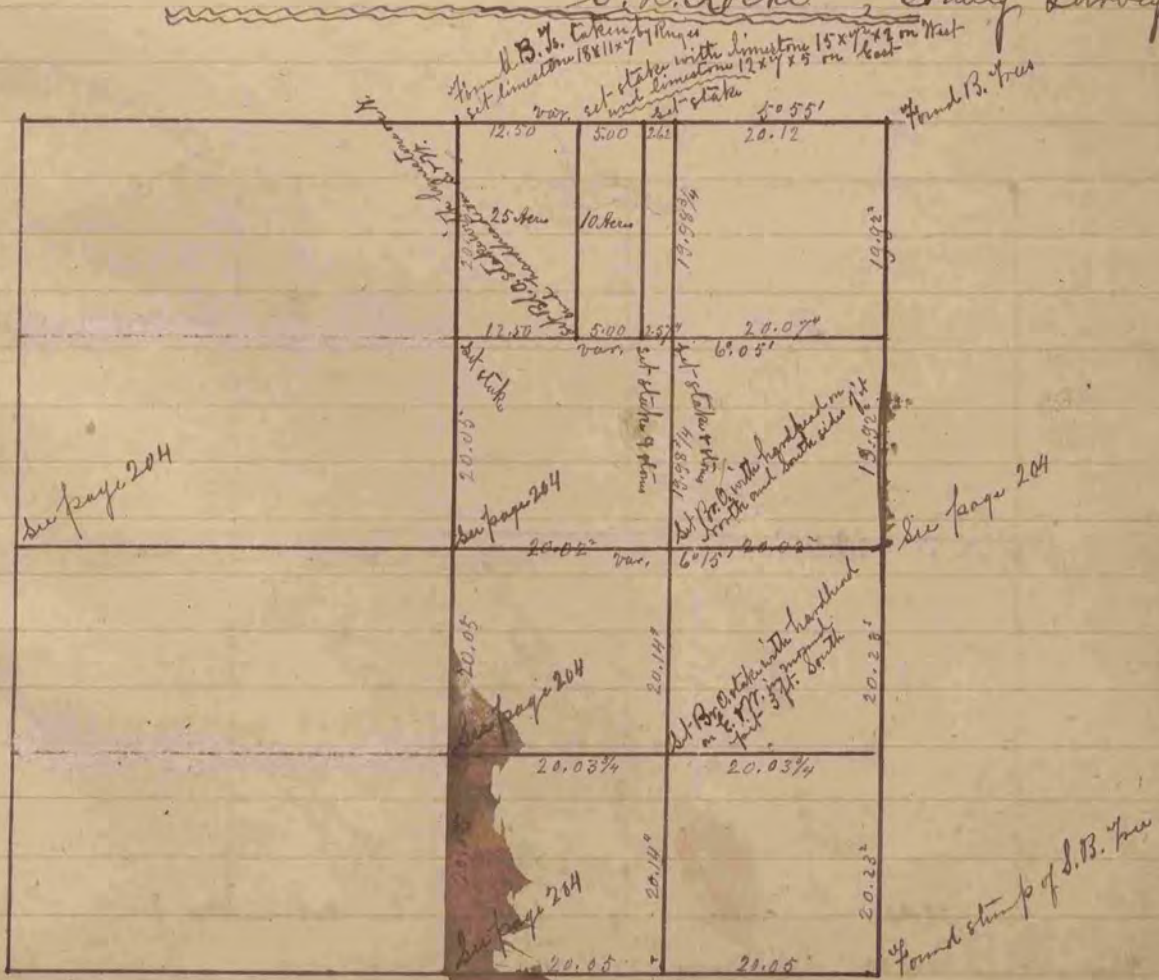

A Record & Plat of a Survey made by me May 29/85, on Sec. 11, Town of Burlington -

S. D. Locke County Surveyor