



Below is a correct Record & Plat of a Survey made by me, June 11th & 12th 1869, on Sec. 25 T.1 R. 13 (Turtle)
 R. H. Lee Dep. Co. Surveyor

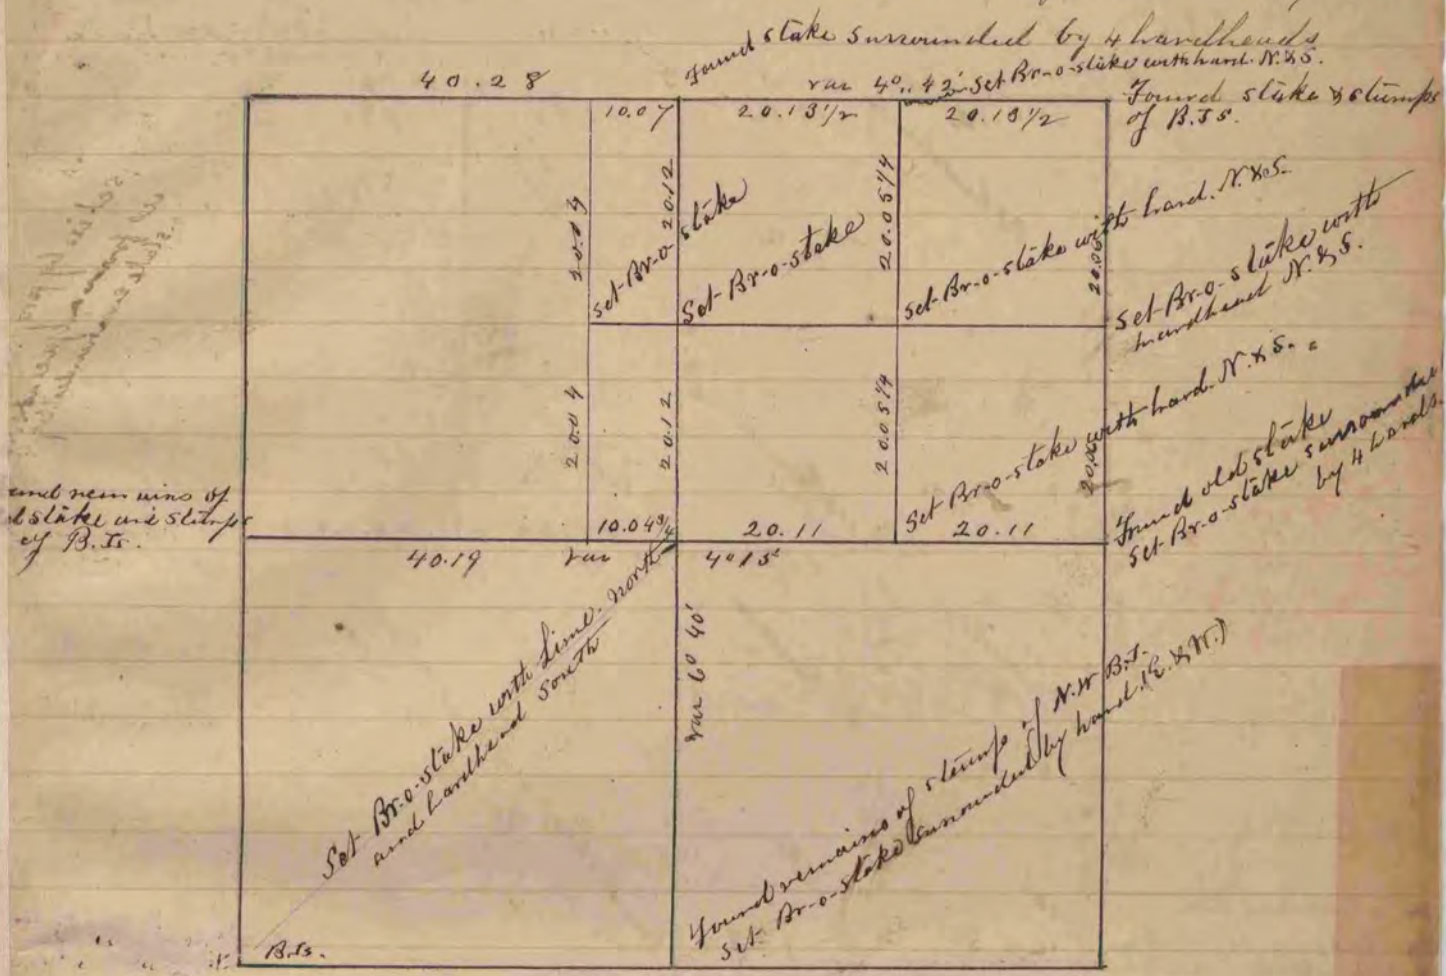

COUNTY SURVEYOR
 RECORD 1 1861-1869

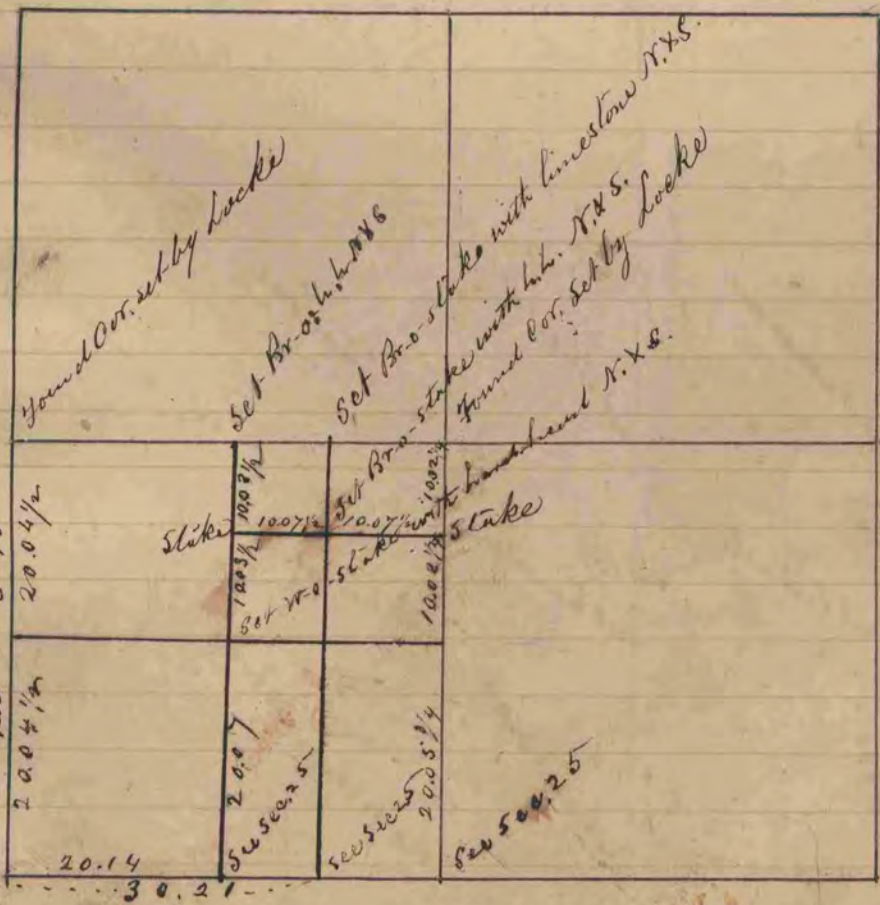

The above is a correct Record & Plat of a Survey made by me June 12th 1869 on Sec. 24 T.1 R. 13 (Turtle)
 R. H. Lee Dep. Co. Surveyor