


Section 25 Township 42 N of Range 14 E
of the Fourth Principal Meridian

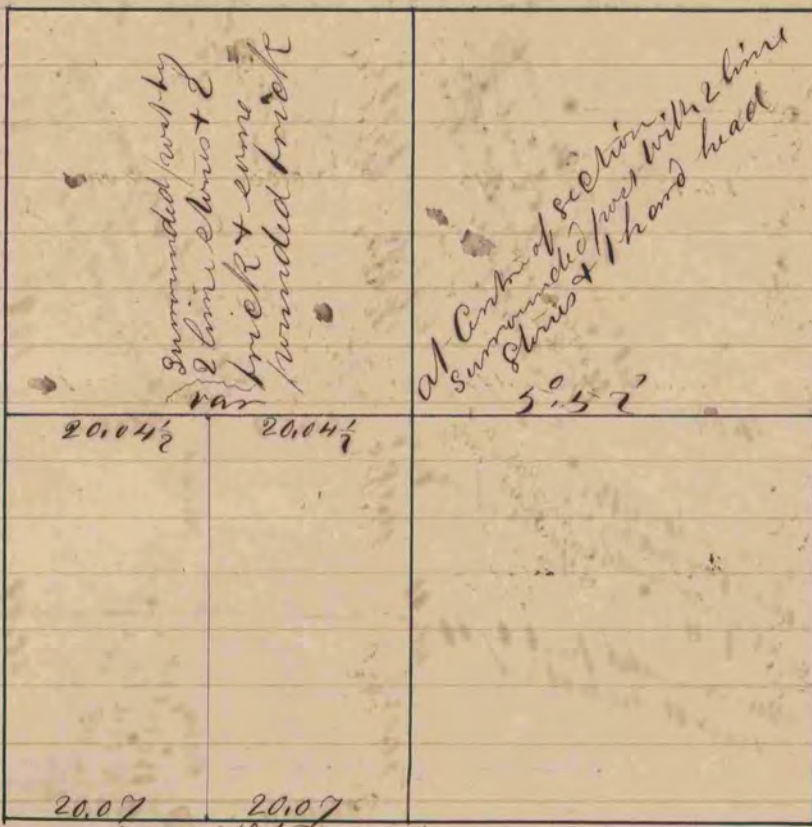

Surrounded part by 4 hard heads

Surrounded part by 4 lime stones

The above survey was made on the 7th of Oct 1859
by Edward Ruger County Surveyor for
Rock County Wisconsin

Bradford