


The above is a correct Record & Plot of a Survey made by me June 20th 1867 on Sec. 12 T. 2 R. 11 E. Plymouth.

R. K. Lee Dep. Co. Surveyor

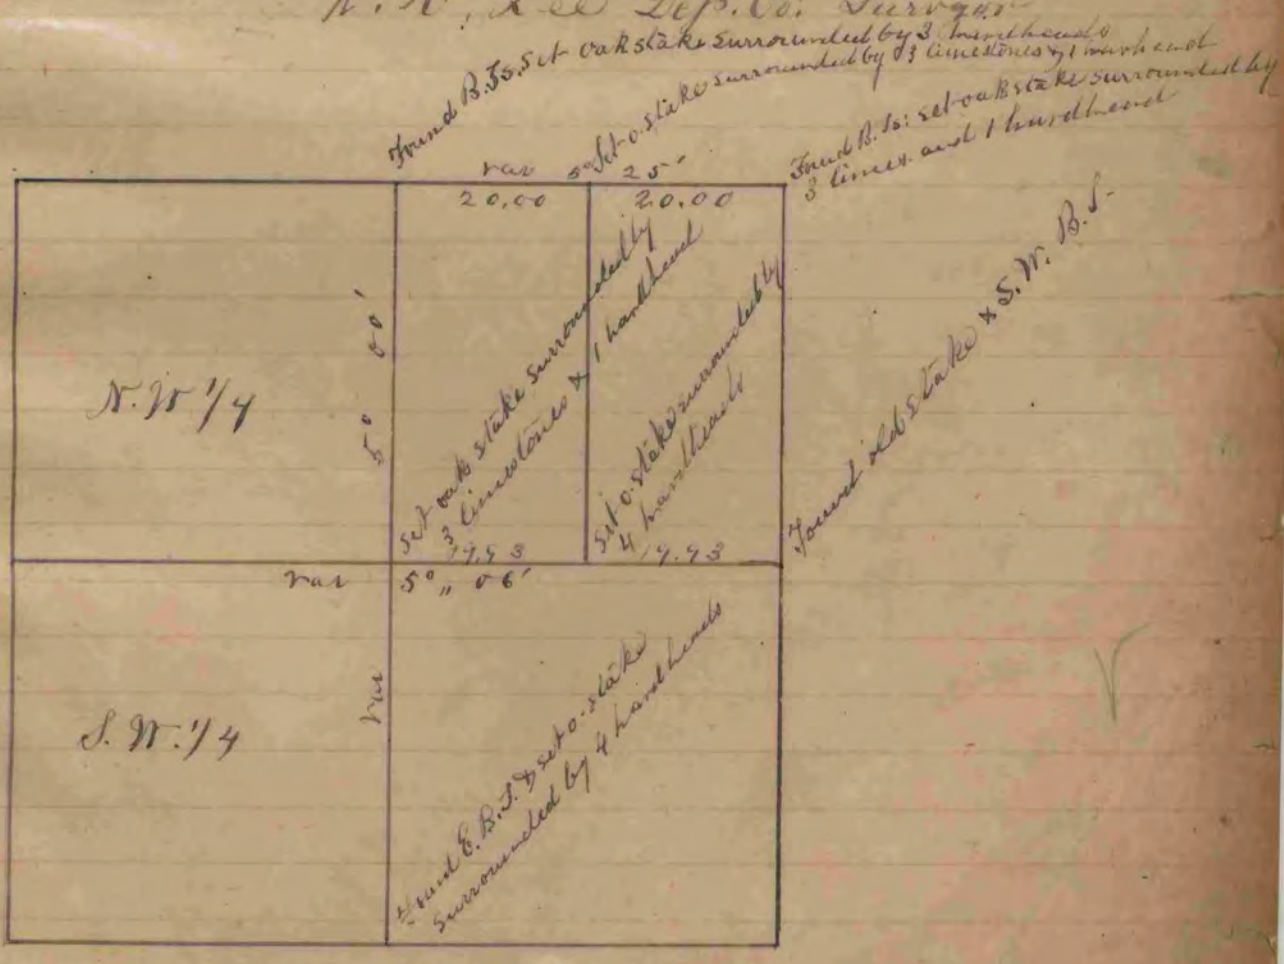

The above is a correct Record & Plot of a survey made by me June 28th & 29th 1867 on Sec. 13 T. 2 R. 14 (Clinton)

R. K. Lee Dep. Co. Surveyor