

RECORD 1859-1906

Set h. 16x8x3 surrounded
it by 8 h.h.

Set lime stone 12x8x3 + set
lime stone on N + S sides

Set h. 14x12 x 9 + surrounded
it by 4 h.h.

Set lime 17x8x7

had been along partition
for corner

Set h. 12x8x7
surrounded by 4 h.h.

Set lime stone 12x6x3
surrounded by 3 lime
stones


Set lime stone 20x16x7 + set sand
stone on S + lime stone on N sides

Set lime stone 18x6x5

Set h. 15x8x7

Set lime stone 14x6x8

Set lime stone 18x6x6 +
surrounded it with small
lime stones

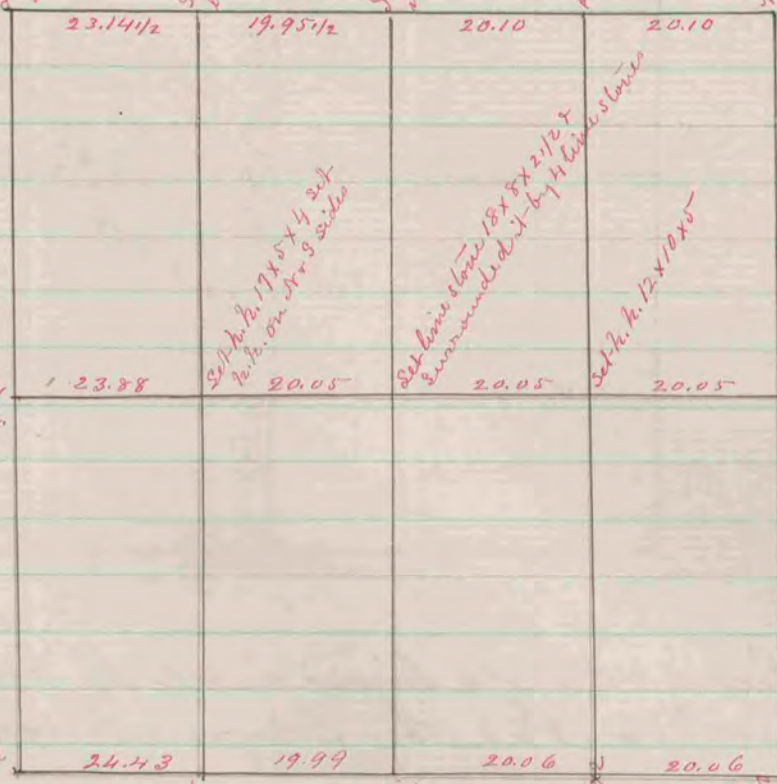

A Record & Plat of a survey made on Dec. 19 74
N. H. Nov. 9th 1860 by Edward Reger Co. Surveyor
Union

COUNTY SURVEYOR
RECORD 1859-1906