


Survey on Sec. 30 T. 1. N. R. 13 E June 10 - 1869

By E. J. Hobart
Dep. Co. Surveyor

Courses according to the true meridian
Var. 50 30'
Measurements in links -

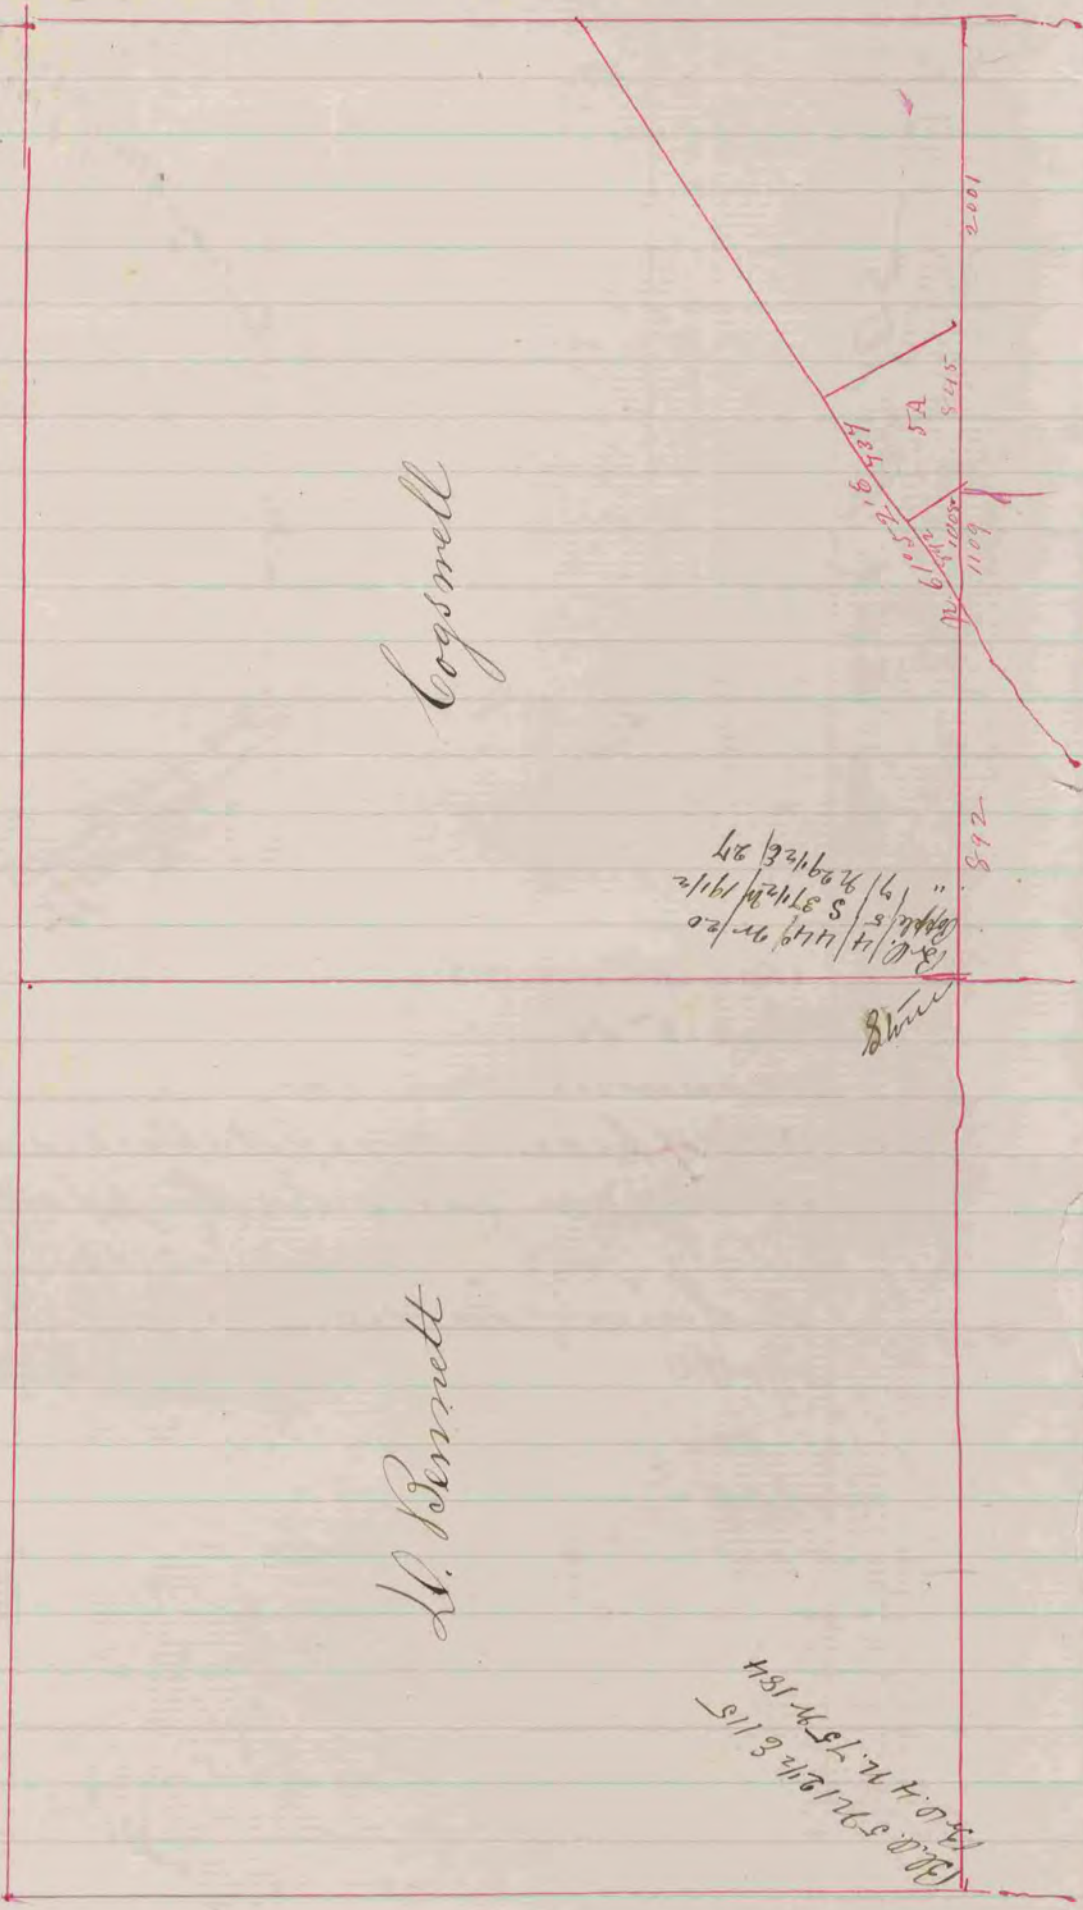

COUNTY SURVEYOR
RECORD 1859-1906