


26-85

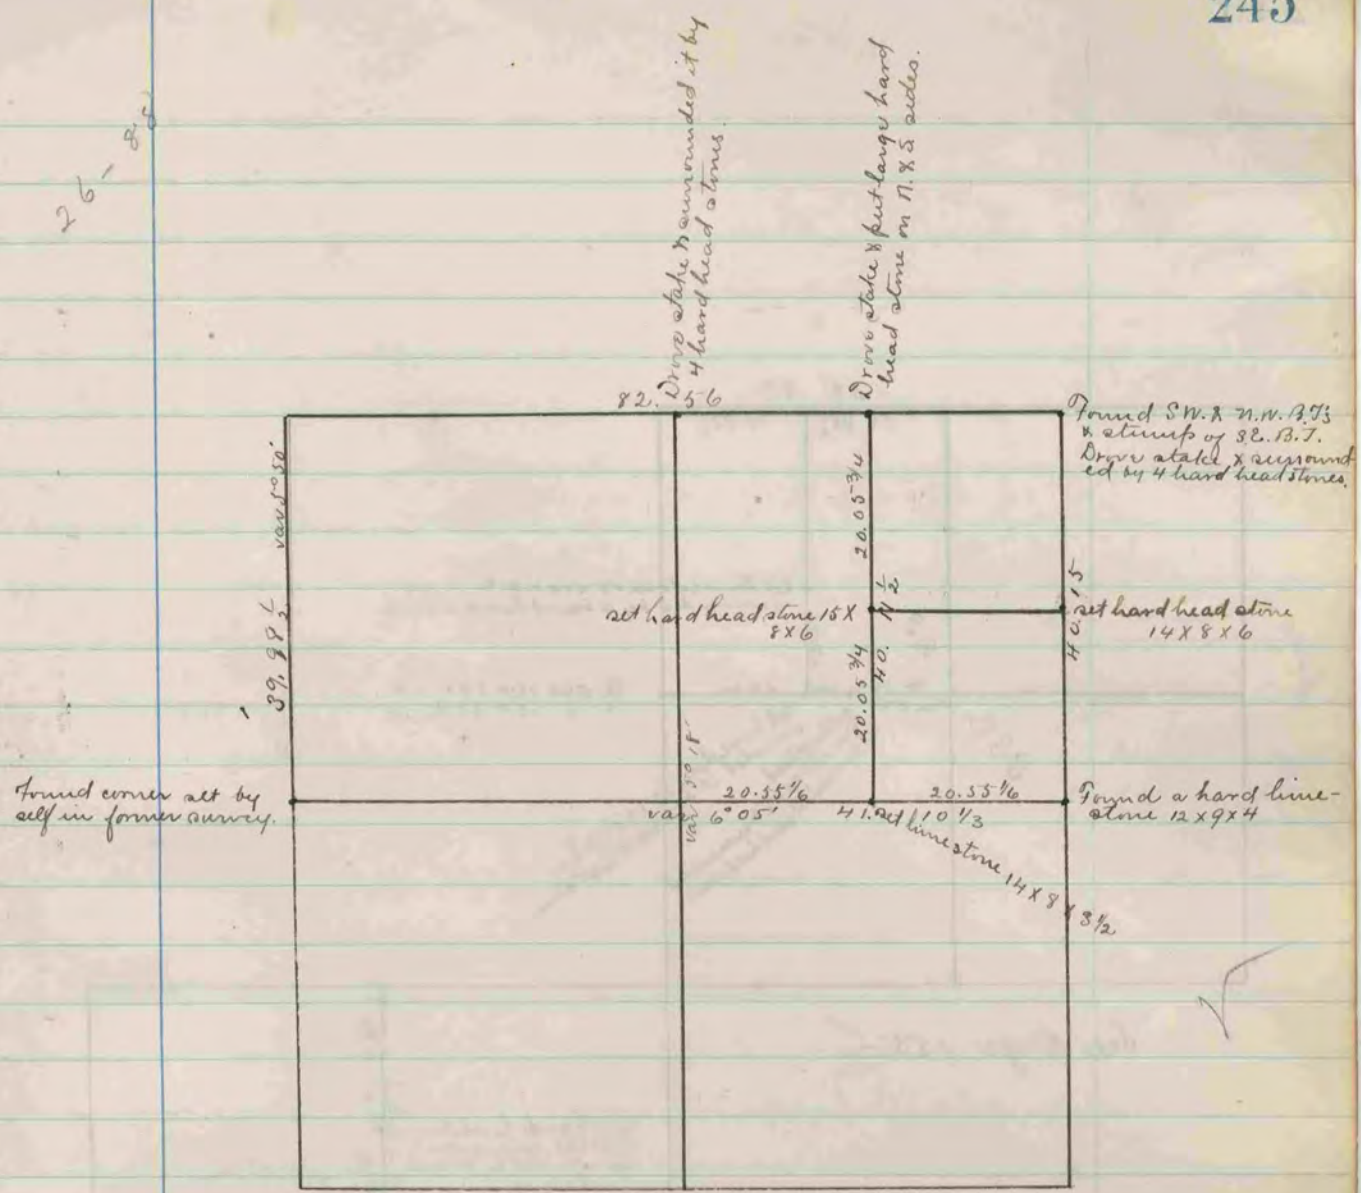

The above is a record & plat of a survey made by me on Sec. 23 Porter, June 13th 1885.

Edward Rieger
County Surveyor

COUNTY SURVEYOR
RECORD 2 1869-1900