


(Recorded in Vol I page 159)

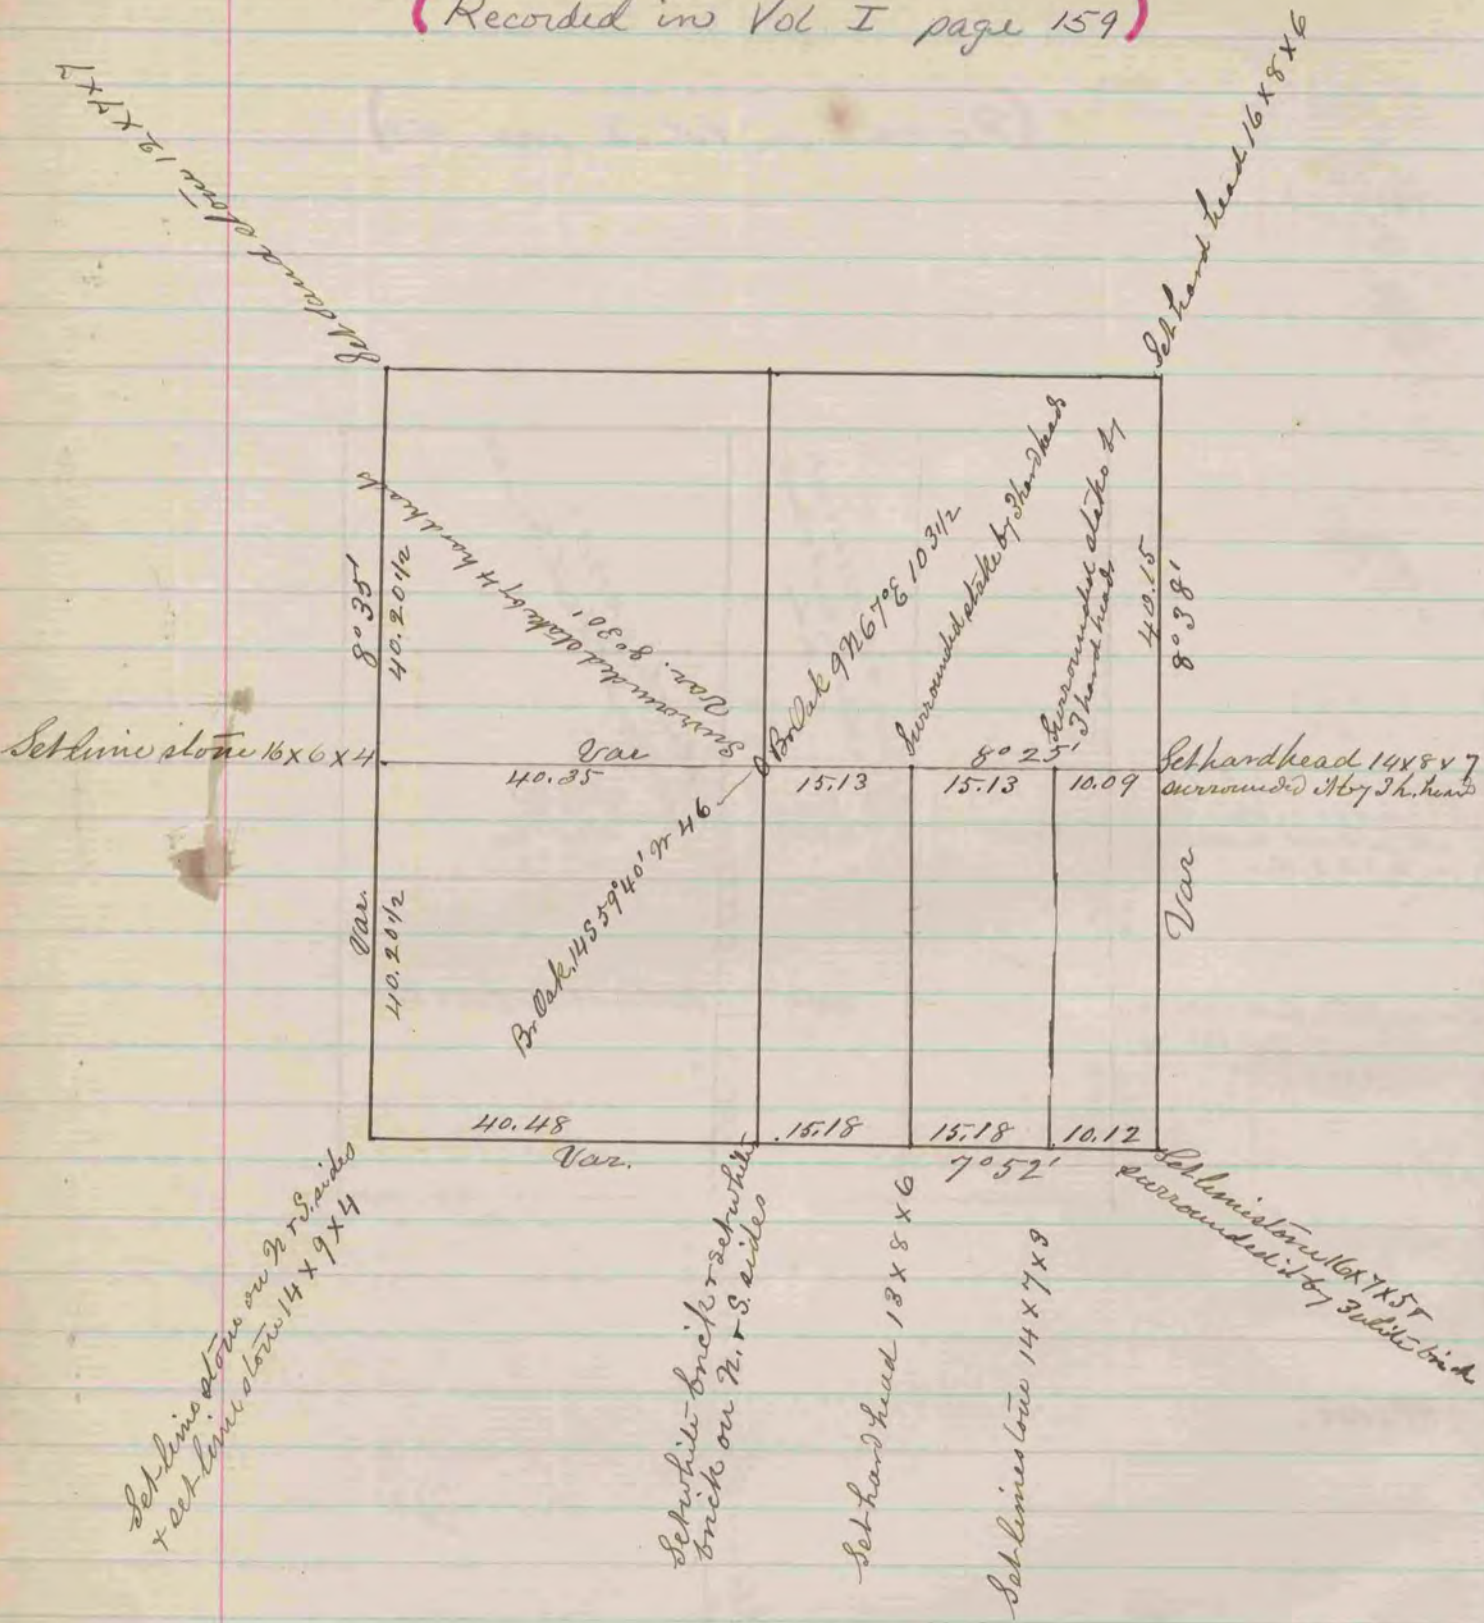

A Record of 7 plat of Survey made on Sec. 8
 T. 3. R. 12 April 19-1861
 by Edward Ruzer
 County Surveyor for Rock Co. Wis.

ROCK COUNTY SURVEYOR
 RECORD 1859-1906