


Set line stone 14x9 x 2 1/2
cut down 2 line stones at
the sides

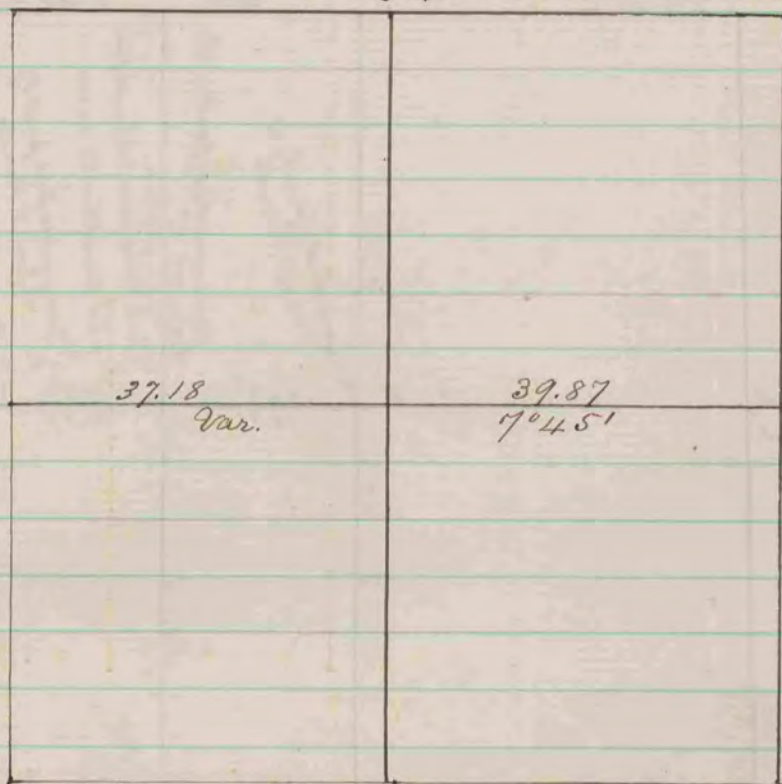

A Record and plat of a survey made on section
18 Town 3 Range 12 April 17 1860
Tannerville by Edward Ringer Co. Surveyor
of Rock County.

(Recorded in Vol I page 130)

RECORD SURVEYOR
COUNTY SURVEYOR

COUNTY SURVEYOR
RECORD 1859-1906