

A Record & Plat of a survey made on Sec. 34  
T. 2. R. 12 E. Rock

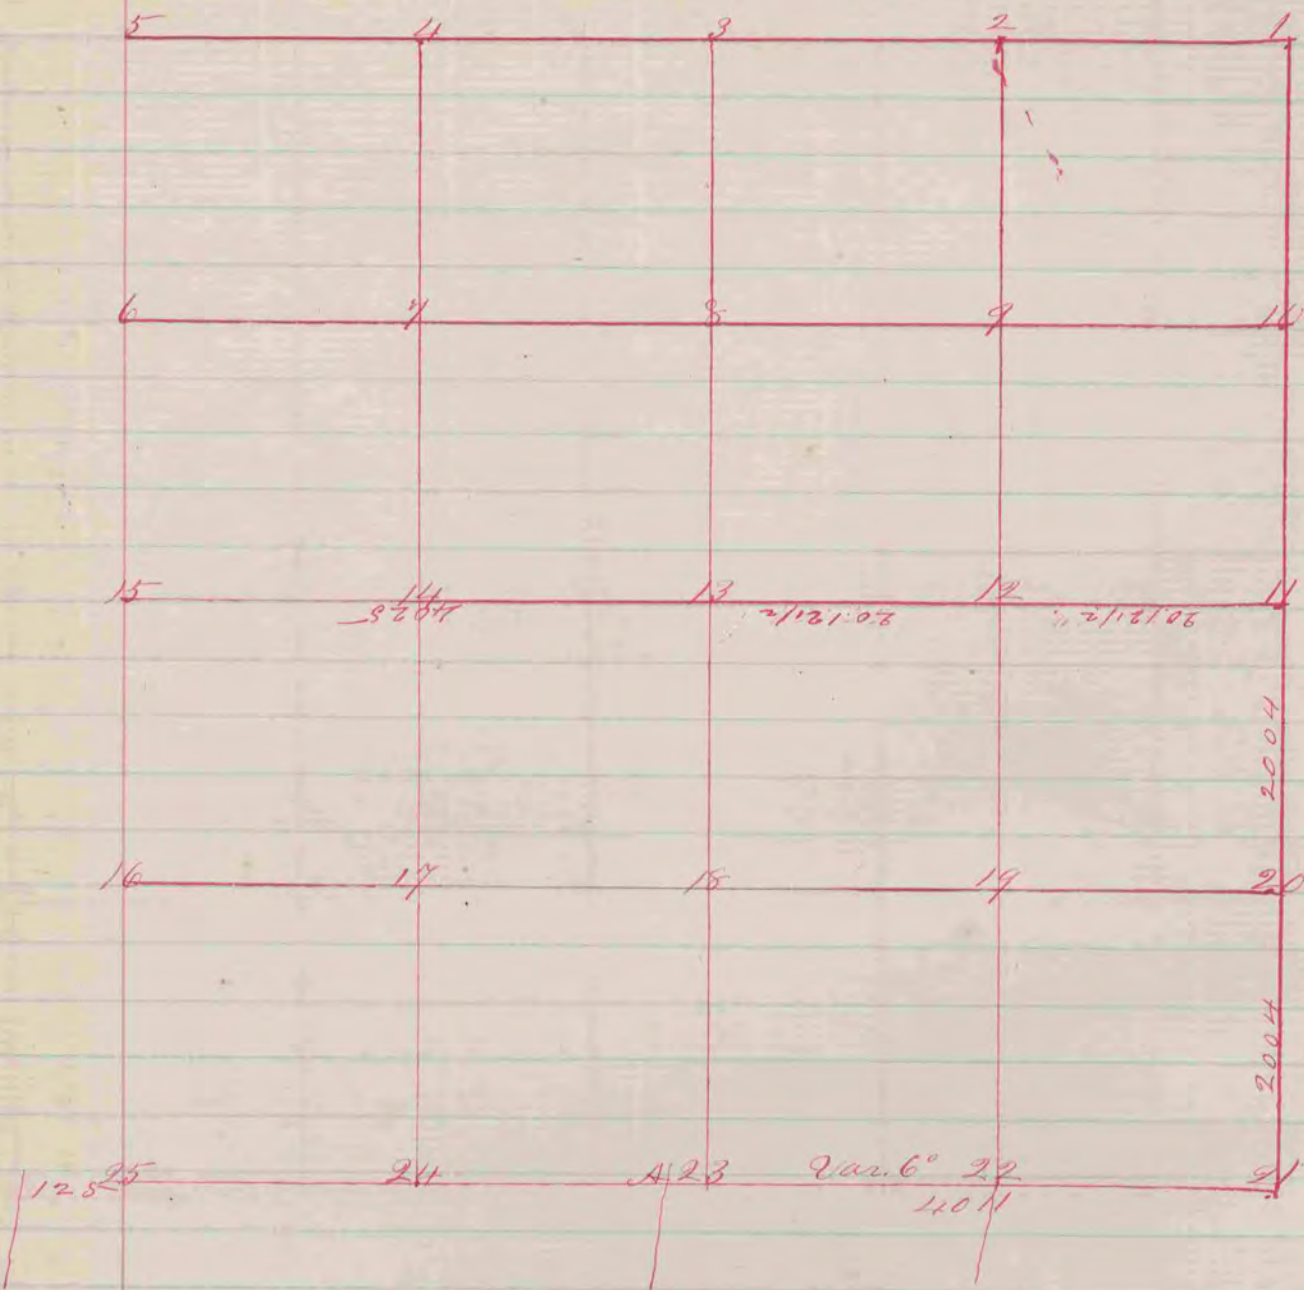


Fig 13 Stake marked on the Prairie no bearings

18 " " " " " "

21 " " in the Centre of highway

Set a on the S. line in the centre between

" B & Fig. 21 one Stake marked no bearings

The above survey was made June 11. 1858

Joseph Church Co. Surveyor

(Recorded in Vol I page 80)