


COUNTY SURVEYOR
RECORD 1859-1906

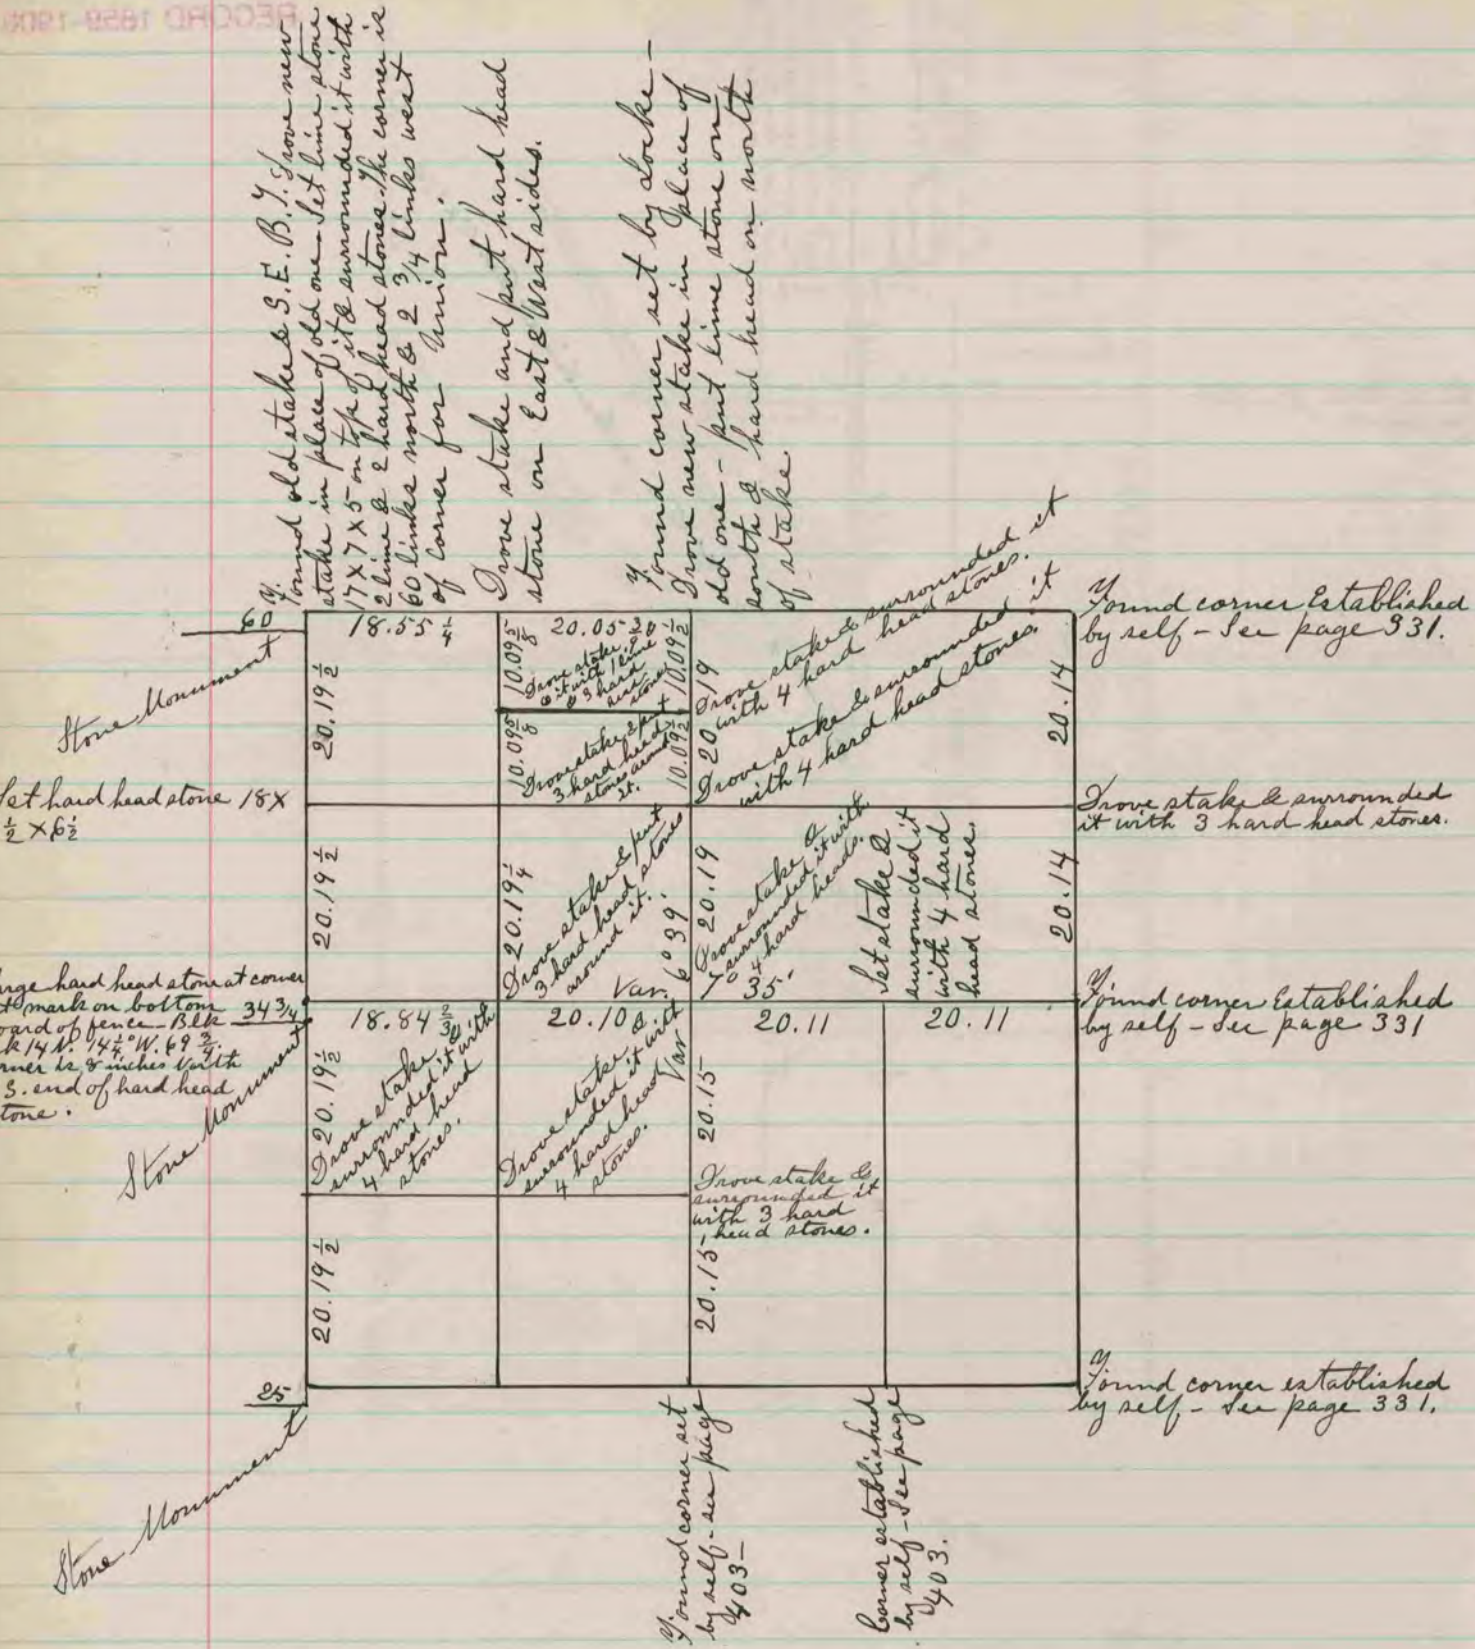

The above is a record & plat of a Survey made by me on Section 30 Porter - Dec. 22, 23 & 24 - 1874

Edward Ruger
County Surveyor.

COUNTY SURVEYOR
RECORD 1859-1906