


all line down 20x15x6

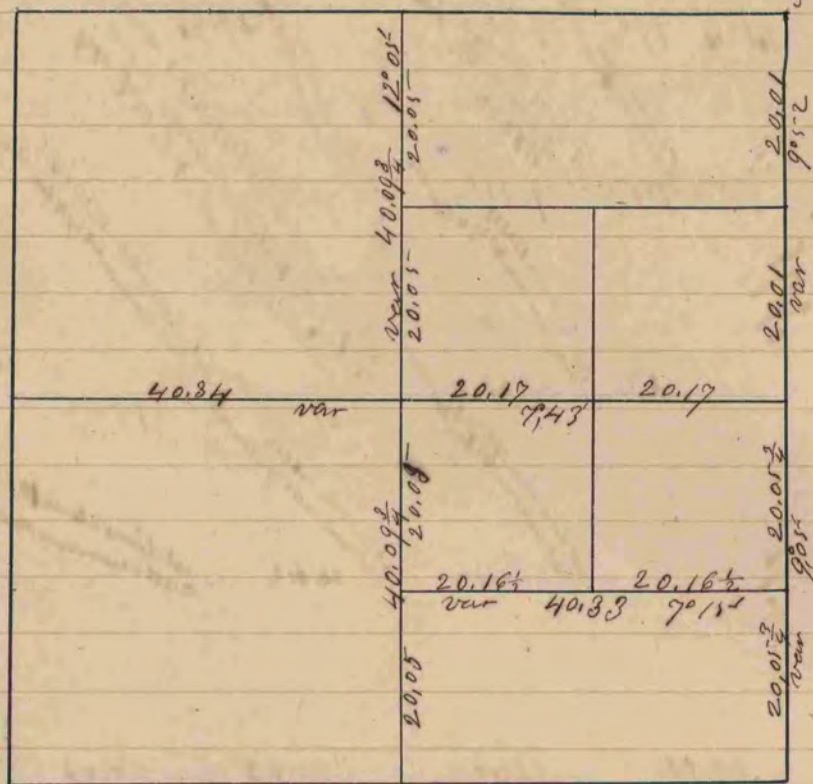

A record and plat of a survey made on Sec
 20 Town 2 Range 13 Date of survey April 27th 1860
 surveyed by Edward Ringer
 County Surveyor for Rock County

COUNTY SURVEYOR
 RECORD 1 1851-1860