


64
at record and plot of a
Survey of the 26 town four range ten East

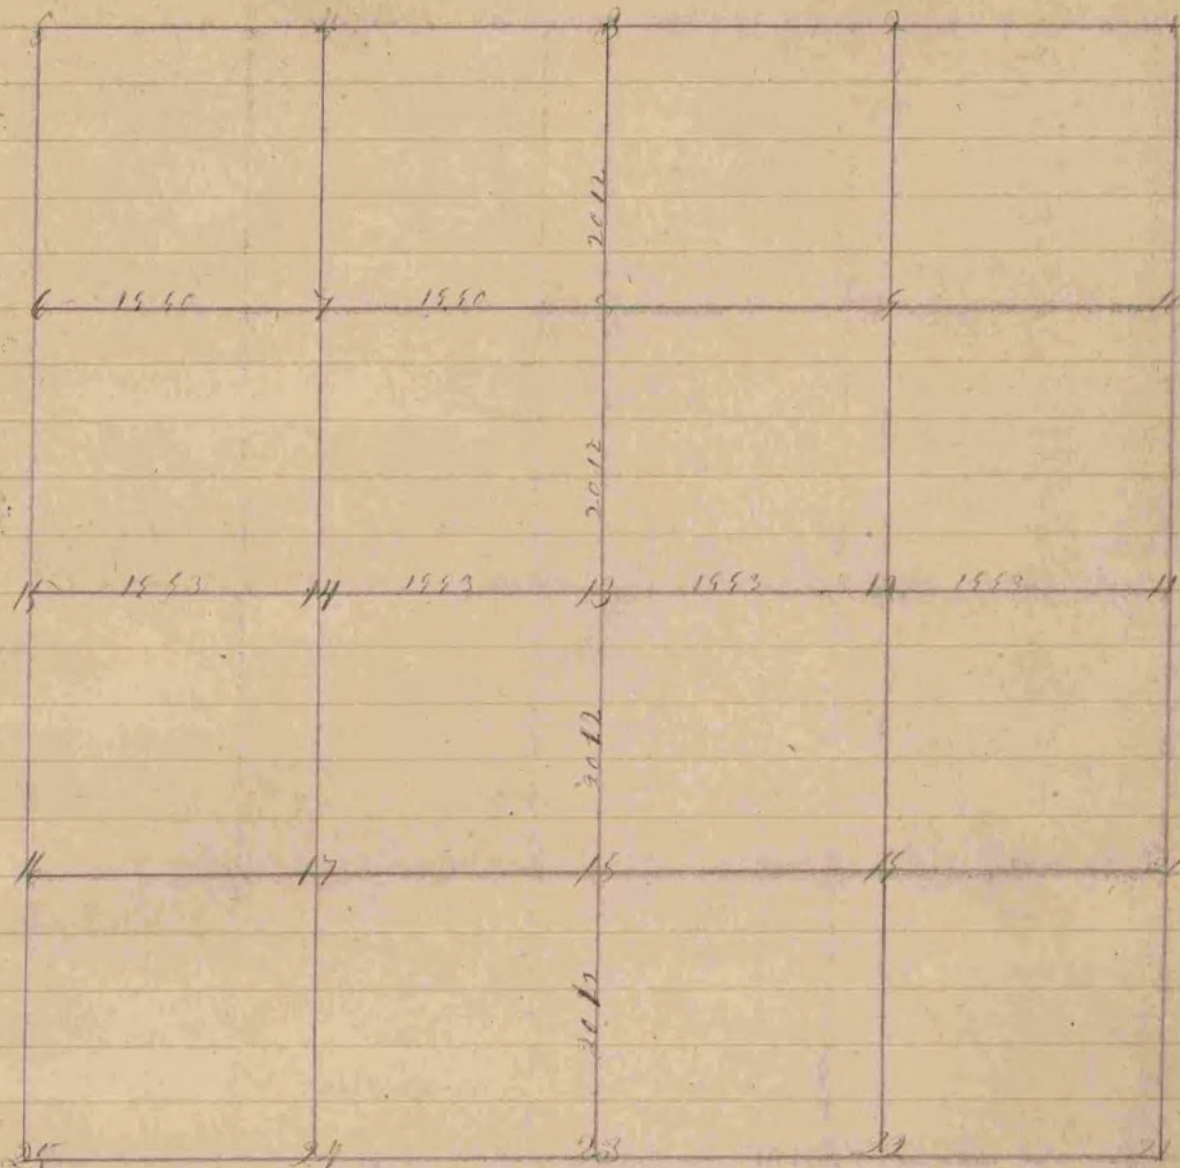

- Fig 13 B.S. 20 of 55 E 215
- " 30 of 55 E 3127
- 12 " 20 of 55 E 131
- " 20 of 50 E 121
- 7 " 24 of 70 E 47
- " 30 of 70 E 4071
- 14 Stake in Centre of Road to Barrens

This above Survey was made the 21st day of March 1851
Joseph Church
County Surveyor
Rock County Wis