


Found corner set by
Locke - Drove new stake
in place of old one &
⊙ by 4 h.h. stones.

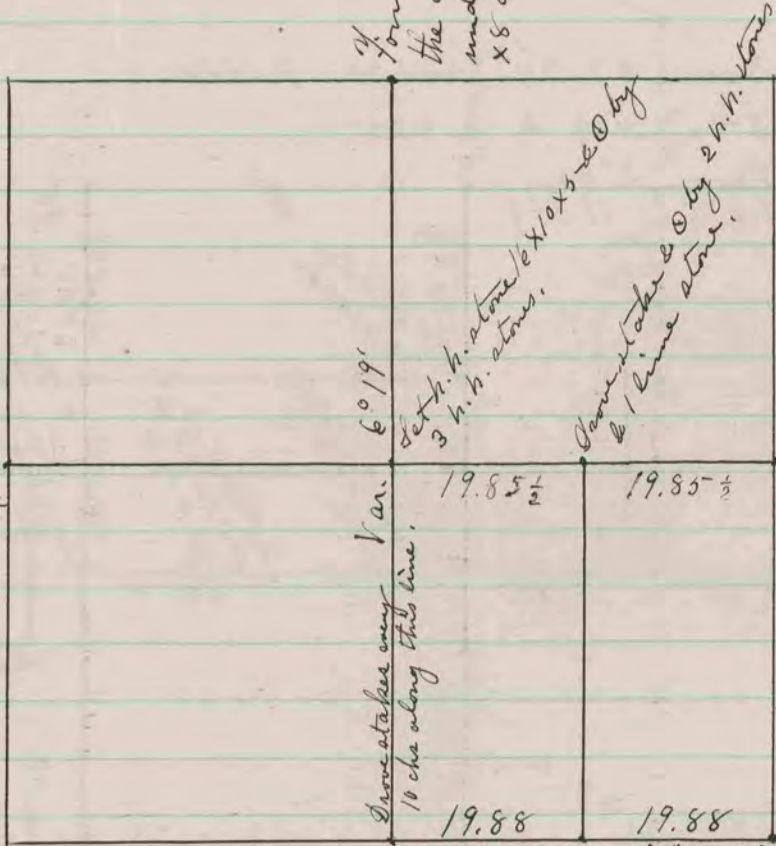

Found old stake also found N.
W. P. Y. gone - Drove stake & ⊙
by 4 small h.h. stones.

Drove stake & put h.h. stone
on the N. & S. sides.

Found lime stone on corner
x 8 x 4 & remains of old stake
under it - also found N.E.P.Y.
& stump of S.W.P.Y. removed
stake & replaced stone.

Found 2 h.h. stones 1 on top of
the other - & remains of old stake
under them - set h.h. stone 22 x 10
x 8 & ⊙ by 4 h.h. stones.

Set h.h. stone 6 x 10 x 8 ⊙ by
3 h.h. stones.

Drove stake & ⊙ by 2 h.h. stones
& 1 lime stone.

Found S.E.P.Y. & stump
of S.W.P.Y. also found
h.h. stone 16 x 10 x 8 on top
of lime stone laid flat.
& remains of old stake
under stones - Replaced
stake & stones.

The above is a record and plat of a survey
made by me on Sec. 22 Porter - April
9 - 1878

Edward Ringer
County Surveyor.