

A record of the Starting Stone of Village of Cransville town  
four range ten East and on Sec 27

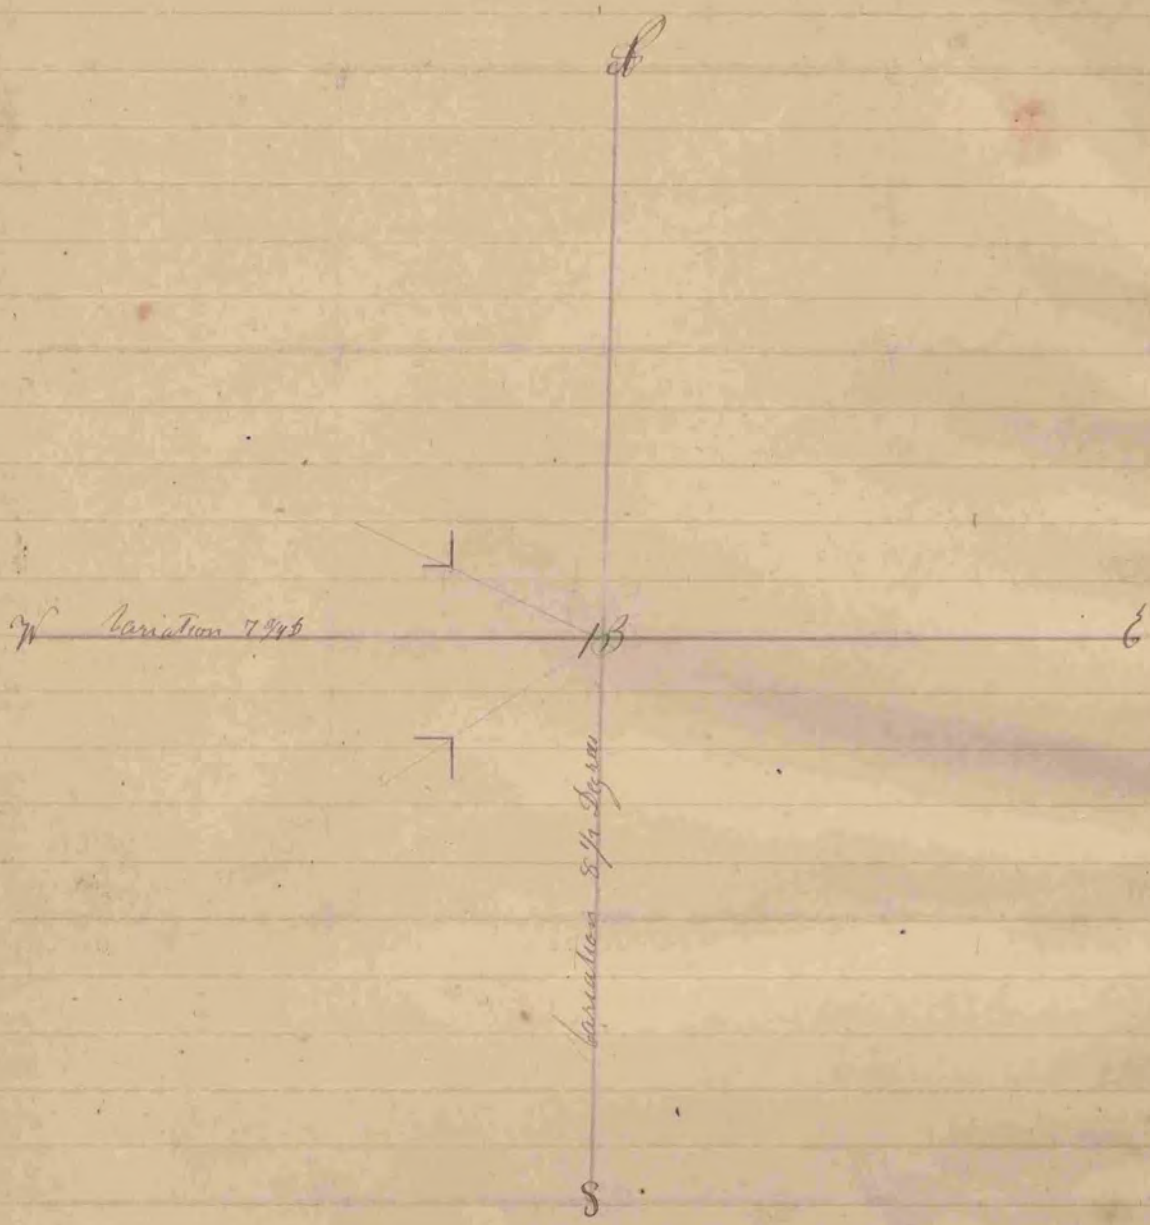


Fig 13 Spencer house N<sup>w</sup> Corner at 74 1/2 W 163 links  
Winstons New house N<sup>e</sup> Corner at 57 1/2 W 153 1/2 links  
Figure 13 is in the centre of said Section  
The variation was taken without the variation of the meridian  
line The above survey was made in the month of August 1855  
Joseph Church County Surveyor  
Rock County Wis

47  
216  
271  
321