



COUNTY SURVEYOR
RECORD 1859-1906

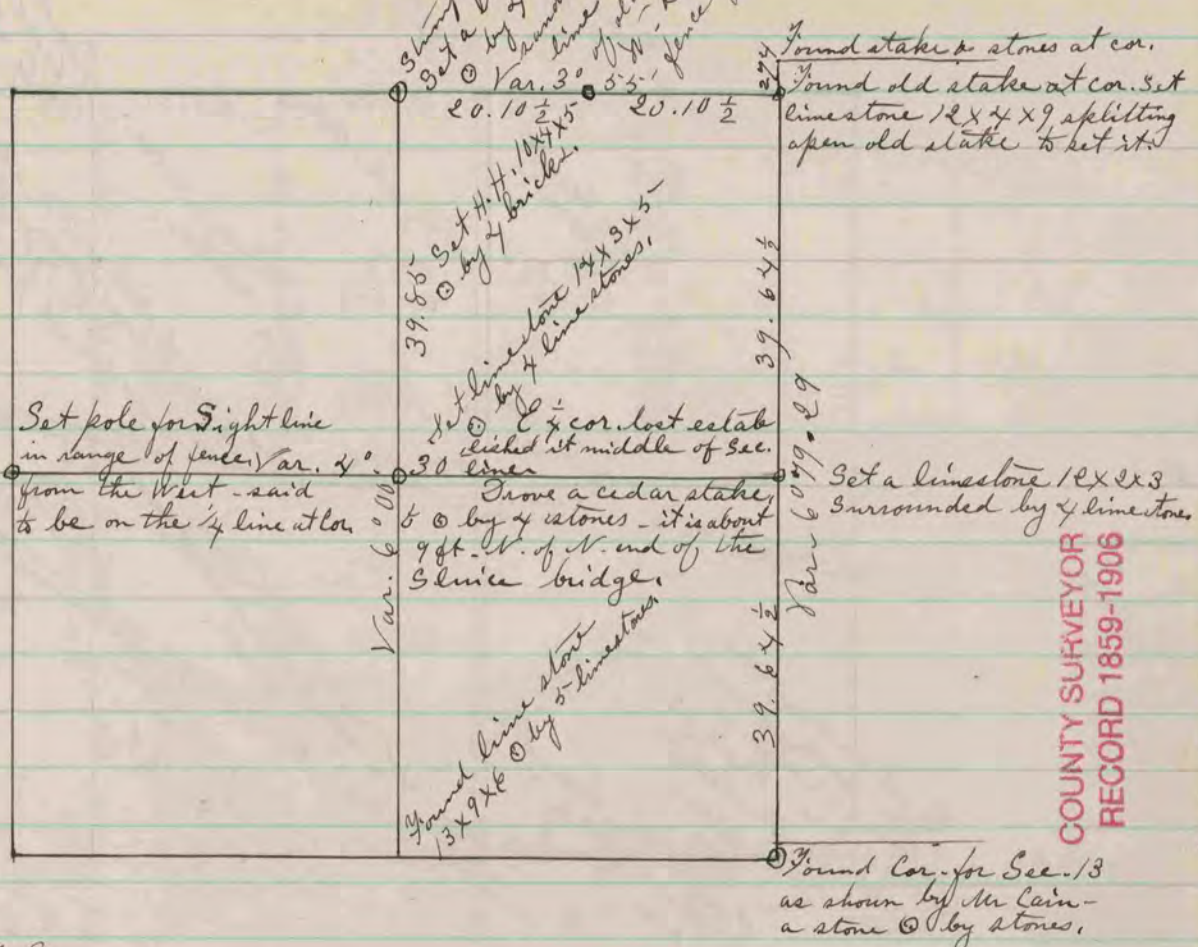

The above is a record & plat of a Survey made by me May 23rd & 24th 1881 on Sec. 13. Magnolia
 R. K. Lee
 Co. Surveyor

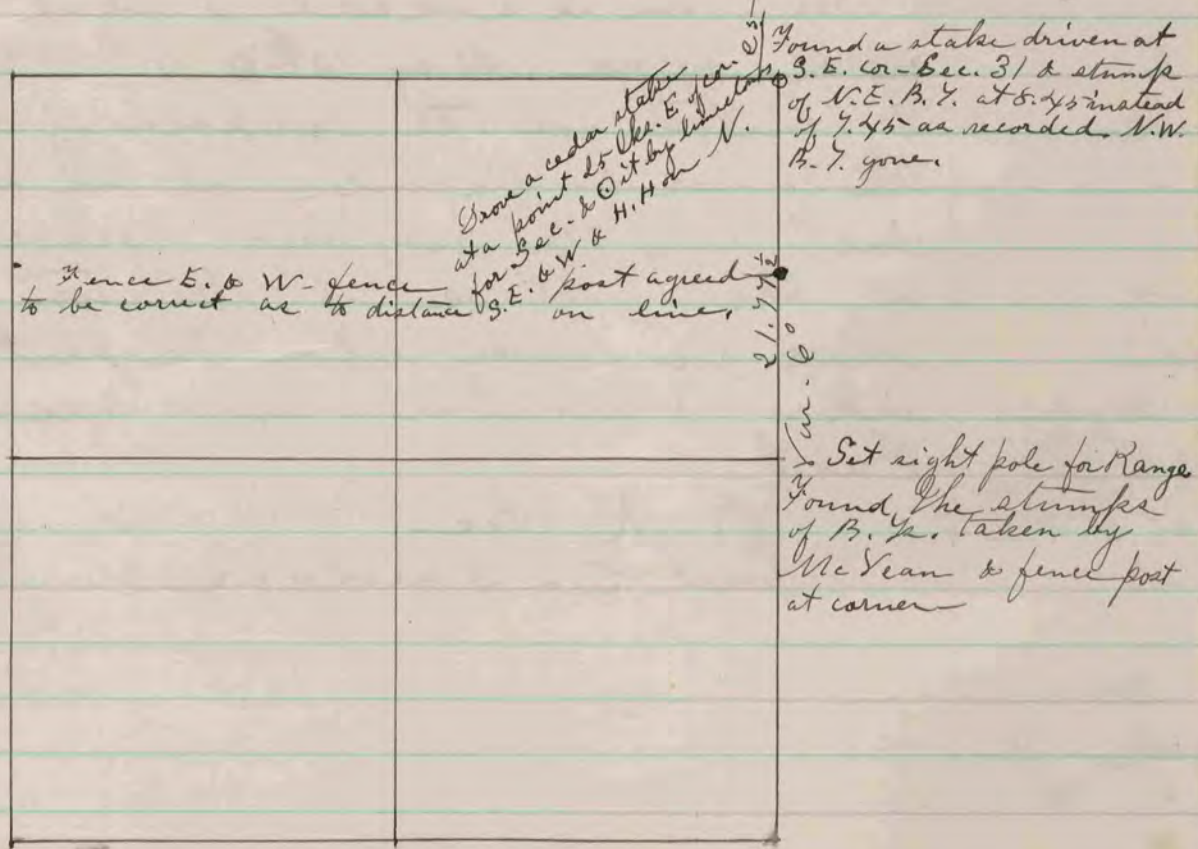

The above is a record & plat of a Survey made by me May 26th 1881 on Sec. 6 Rock
 R. K. Lee
 Dept. Co. Surveyor