

45
A recent survey and plat of a survey made on Sec nine
town two Range ten East

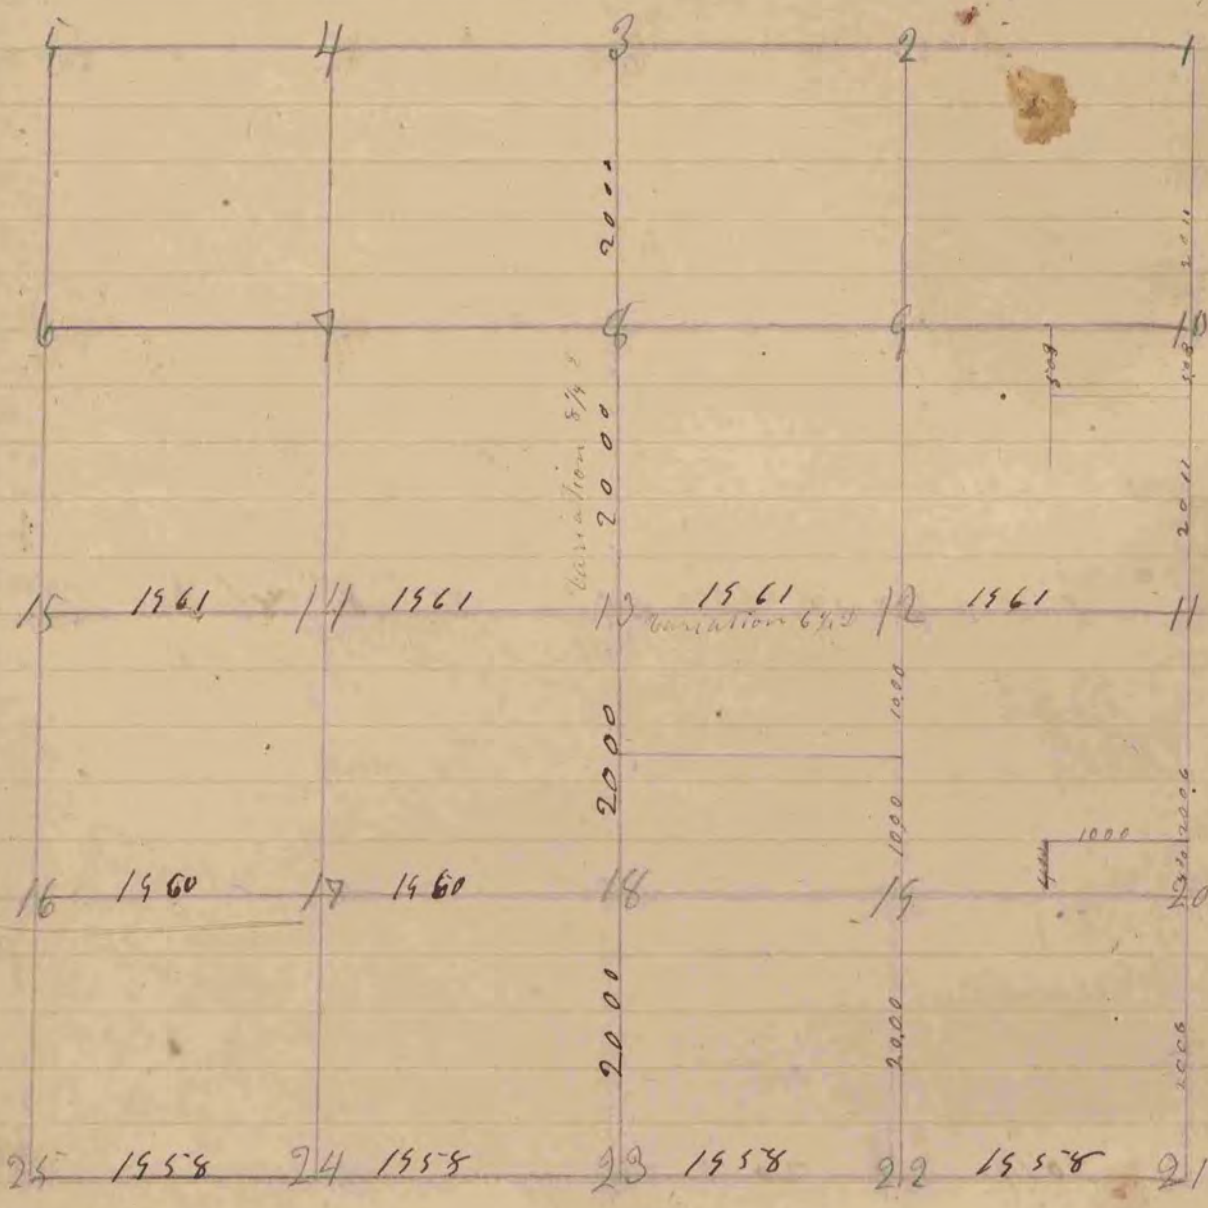


Fig 23 Bur 0 12 N 13 1/2 W 50 7 links 5 1/2 22 30 20 N 54 W 18 1/2
 14 S 4 1/2 E 57 1 - 15 S 35 1/2 W 35
 8 Bur 0 20 S 72 1/2 E 19 - 12 Bur 0 12 N 54 W 53
 18 S 84 W 77 - 20 S 25 E 107 1/2
 13 Bur 0 18 S 19 1/2 W 77 - 15 Bur 0 14 S 65 1/2 E 52
 14 S 61 W 47 1/2 - 20 = 24 S 55 W 52
 14 Bur 0 20 N 36 W 145 10 S 47 1/2 E 57
 20 S 35 1/2 W 135 9 S 19 N 26 1/2 W 77 1/2
 17 - 14 S 71 1/2 W 46 16 S 74 E 36
 15 S 82 1/2 E 34
 18 = 14 S 1 1/2 W 48
 14 N 18 E 81

The above survey was
made Feb 13th 1856
Joseph Church
County Surveyor

The above survey was made the thirteenth and fourteenth
day of June 1853
Joseph Church County Surveyor