


The above is a record & plat of a survey made by me  
 Dec. 27<sup>th</sup> & 28<sup>th</sup> 1880 on Section 27 Bradford  
 R. K. Lee  
 Dept. Co. Surveyor

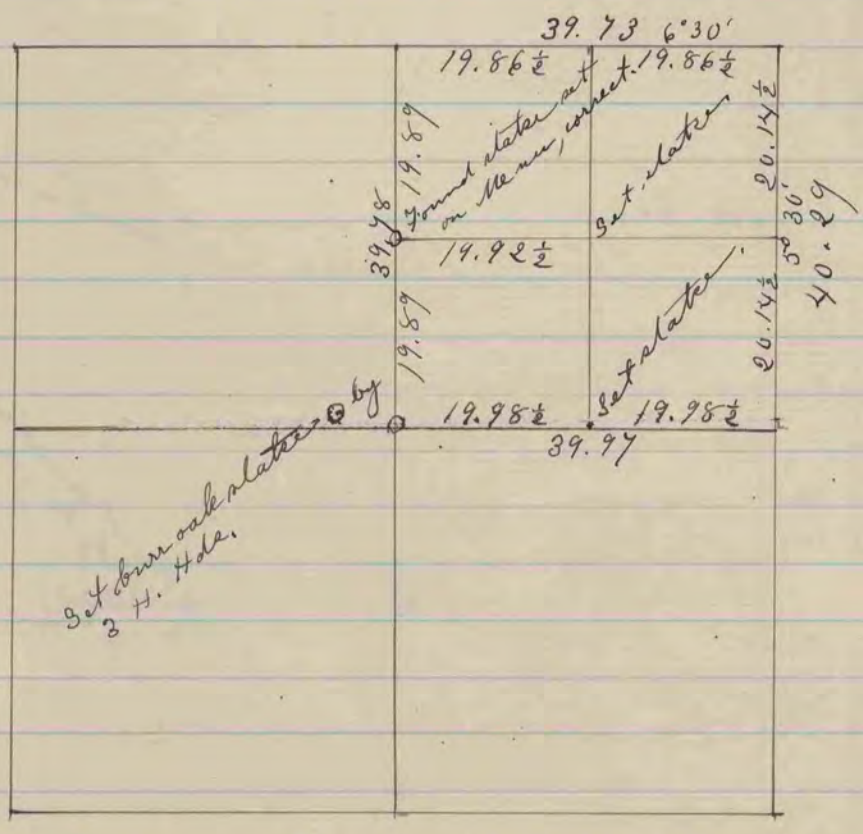

The above is a record & plat of a Survey made  
 by me April 22<sup>nd</sup> 1881 on Section 36  
 Newark  
 R. K. Lee  
 Dept. Co. Surveyor