


COUNTY SURVEYOR  
RECORD 1859-1906

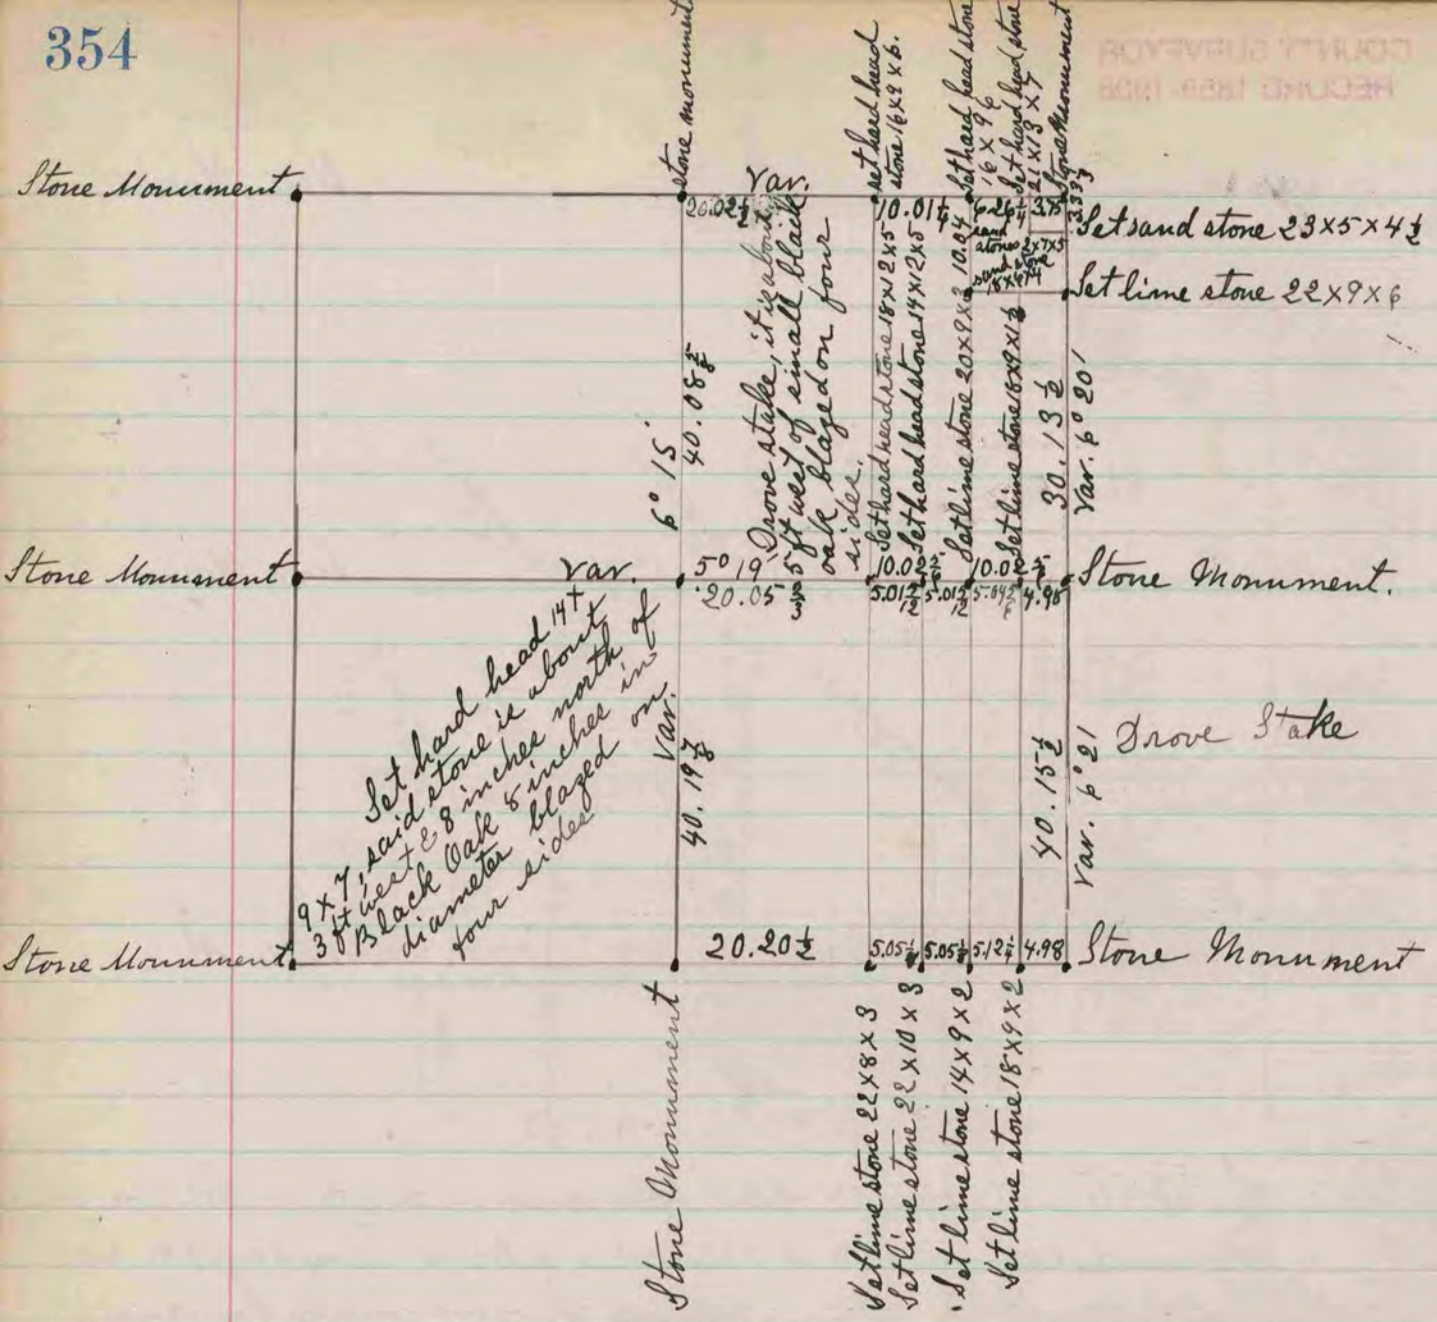

The above is a record and plat of a  
 survey made on Section 34 Plymouth  
 Nov. 21-22 & 24 - 1873 by  
 Edward Ringer  
 County Surveyor

COUNTY SURVEYOR  
RECORD 1859-1906