


Found corner established
by self in a former survey.

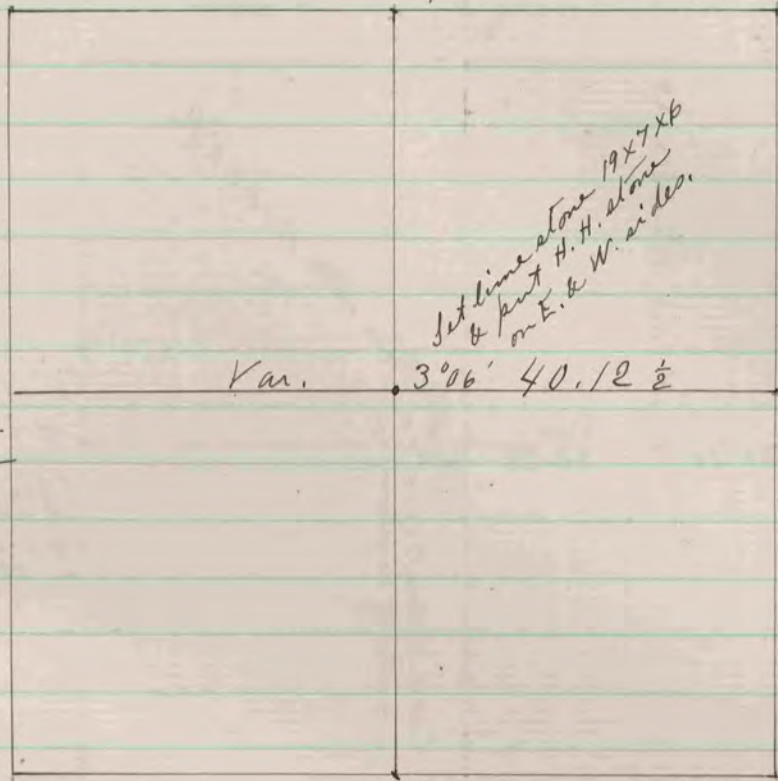

Found where corner
stone had been re-
moved to set fence
post - set H.H. stone
18x9x9 & @ it by
4 H.H. stones.

Found old stake & set
lime stone 24x8x8 &
surrounded it by a lot
of small stones

Found corner established
by self in the survey of
Section 5 Clinton.

The above is a record and plot of a survey
made by me on Section 5 - Clinton -
June 14 - 1878

Edward Rugee
County Surveyor.

COUNTY SURVEYOR
RECORD 1859-1906