


A record and plat made of a survey on Sec Twenty
nine town two Range ten East

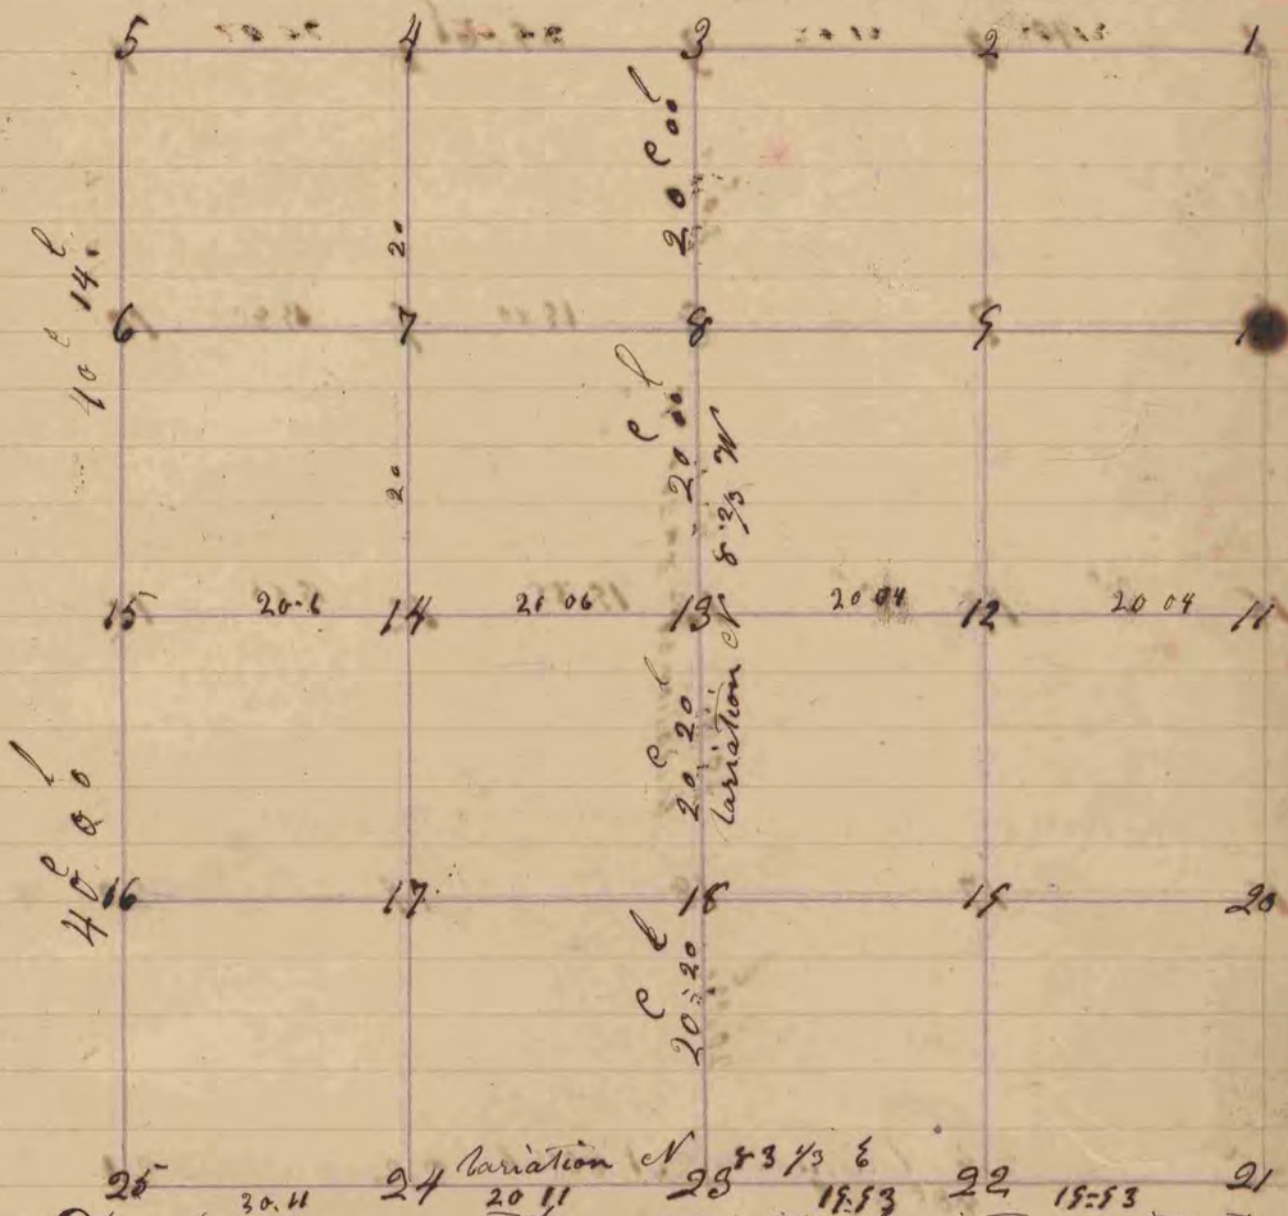

The above survey was taken with or the bearing trees with the
Fig 13 represents the Centre of Sec (variations off of the compass
black 0 8 S 30 1/2 W 183 links Stake
Fig 14 bur 0 16 of 87 6 287 = = = = =
18 = = N 15 W 583 = = = = =
21 = = 16 of 23 W 25 = = = = =
= = N 13 E 30 = = = = =
22 W 0 20 S 65 1/2 W 110 = = = = =
24 bur 0 16 S 8 E 130 = = = = =

The above survey was made Apr tenth 1855
with accordance to ran Joseph Church County Surveyor