


(Recorded in Vol. I page 134)

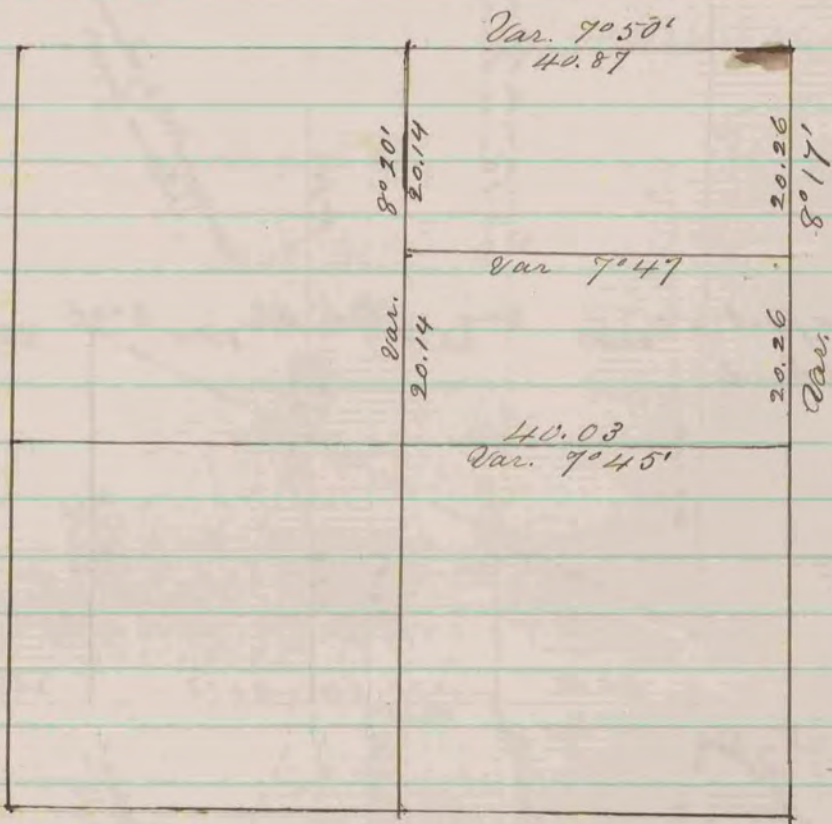

^{r/plot}
 A Record of a survey made on Sec. 22 T. 3. R. 12.
 May 29th 1860 by Edward Reger
 Co. Surveyor for
 Rock County Wis.

COUNTY SURVEYOR
 RECORD 1859-1909

NOT RECORDED