


The above is a correct read and plat of a survey made by me Nov. 12, 13, 14, 1867. on Sec. 36 Union Twp. I.L. Locke, County Surveyor for Rock County Wis.

COUNTY SURVEYOR  
RECORD 1859-1906

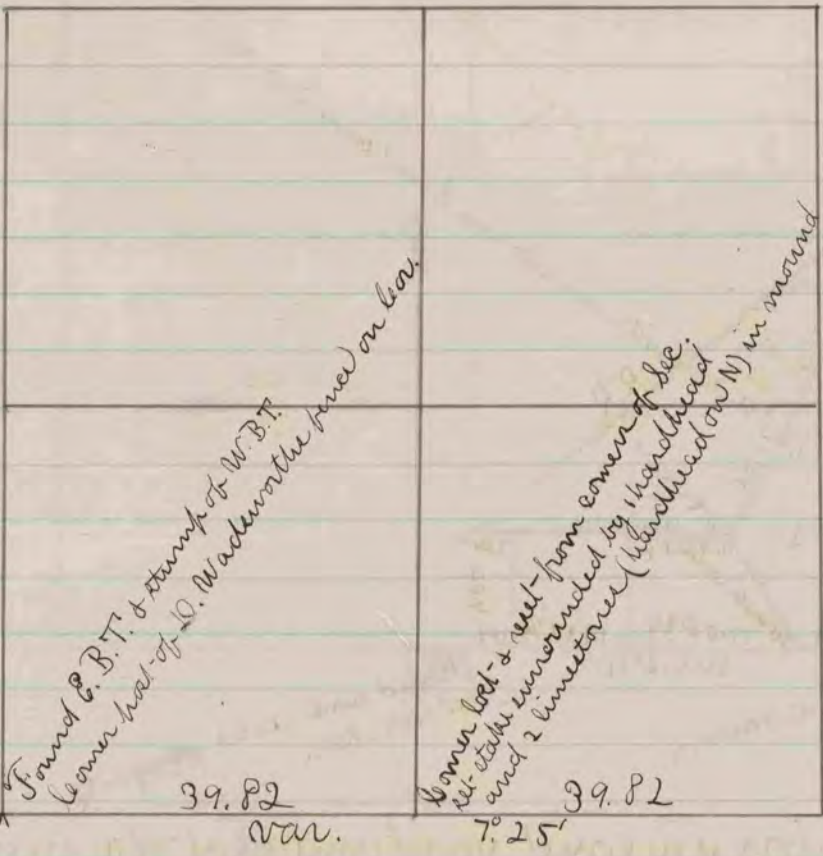

The above is a correct read and plat of a survey made by Nov. 14 & 15, 1867. on Sec. 35 Union Twp. I.L. Locke County Surveyor in & for Rock Co. Wis.