


The above is a correct Record & Plat of a survey made by me Jan 1-2, 3 & 4, 1867 on Sec. 25 - Magnolia.

S. D. Locke Co. Sur. Rock Co. Sur.

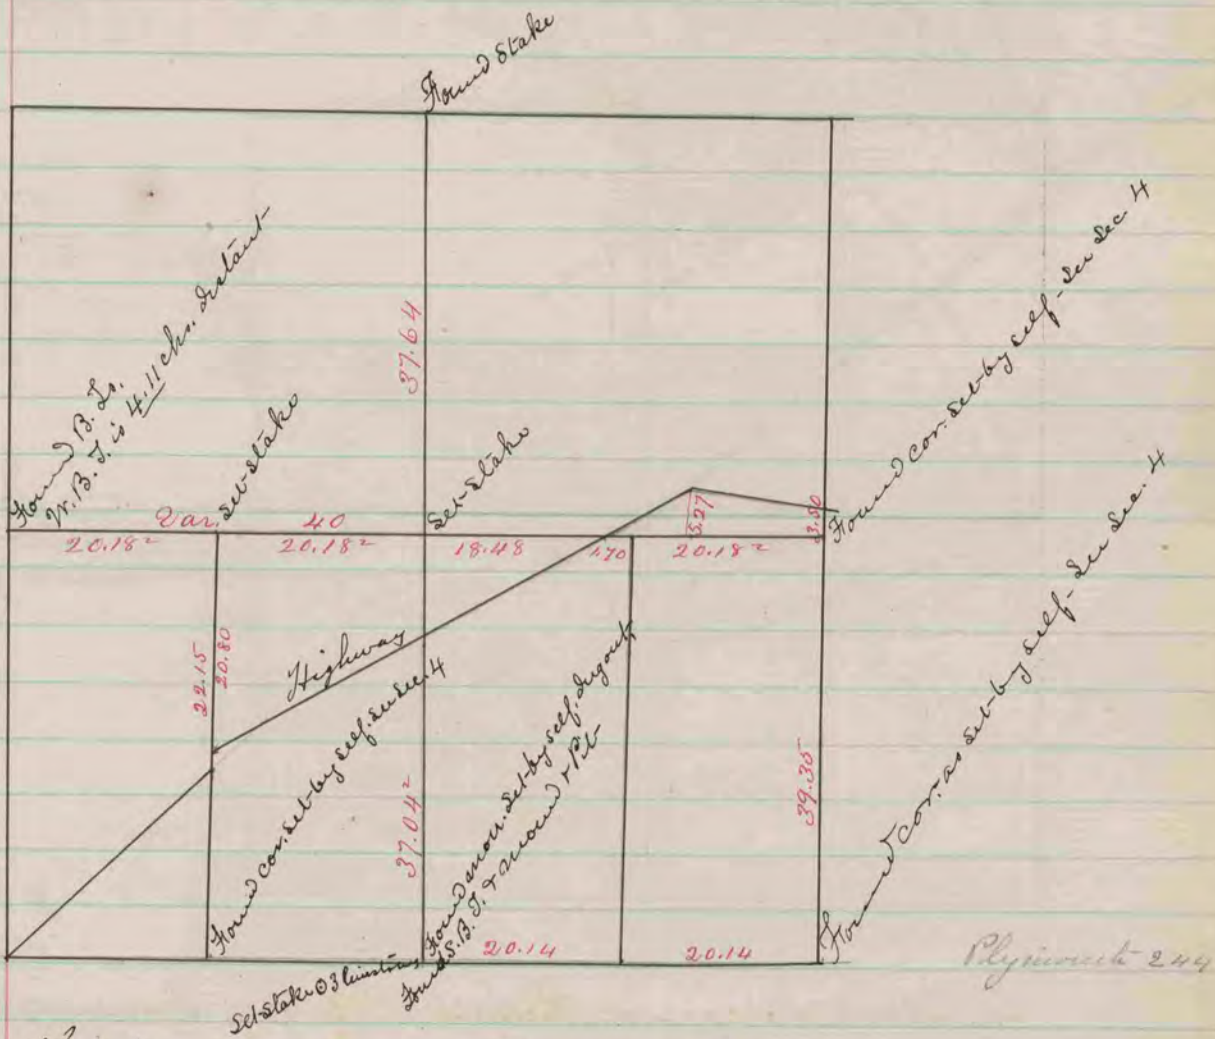

The above is a correct Record & Plat of a survey made by me Jan 9, 1867 on Sec. 5 Plymouth.

S. D. Locke Co. Sur. Rock Co.  
COUNTY SURVEYOR  
RECORD 1859-1906