

82

A Record & Plot of a Survey made on
the Third Town One Range Twp East

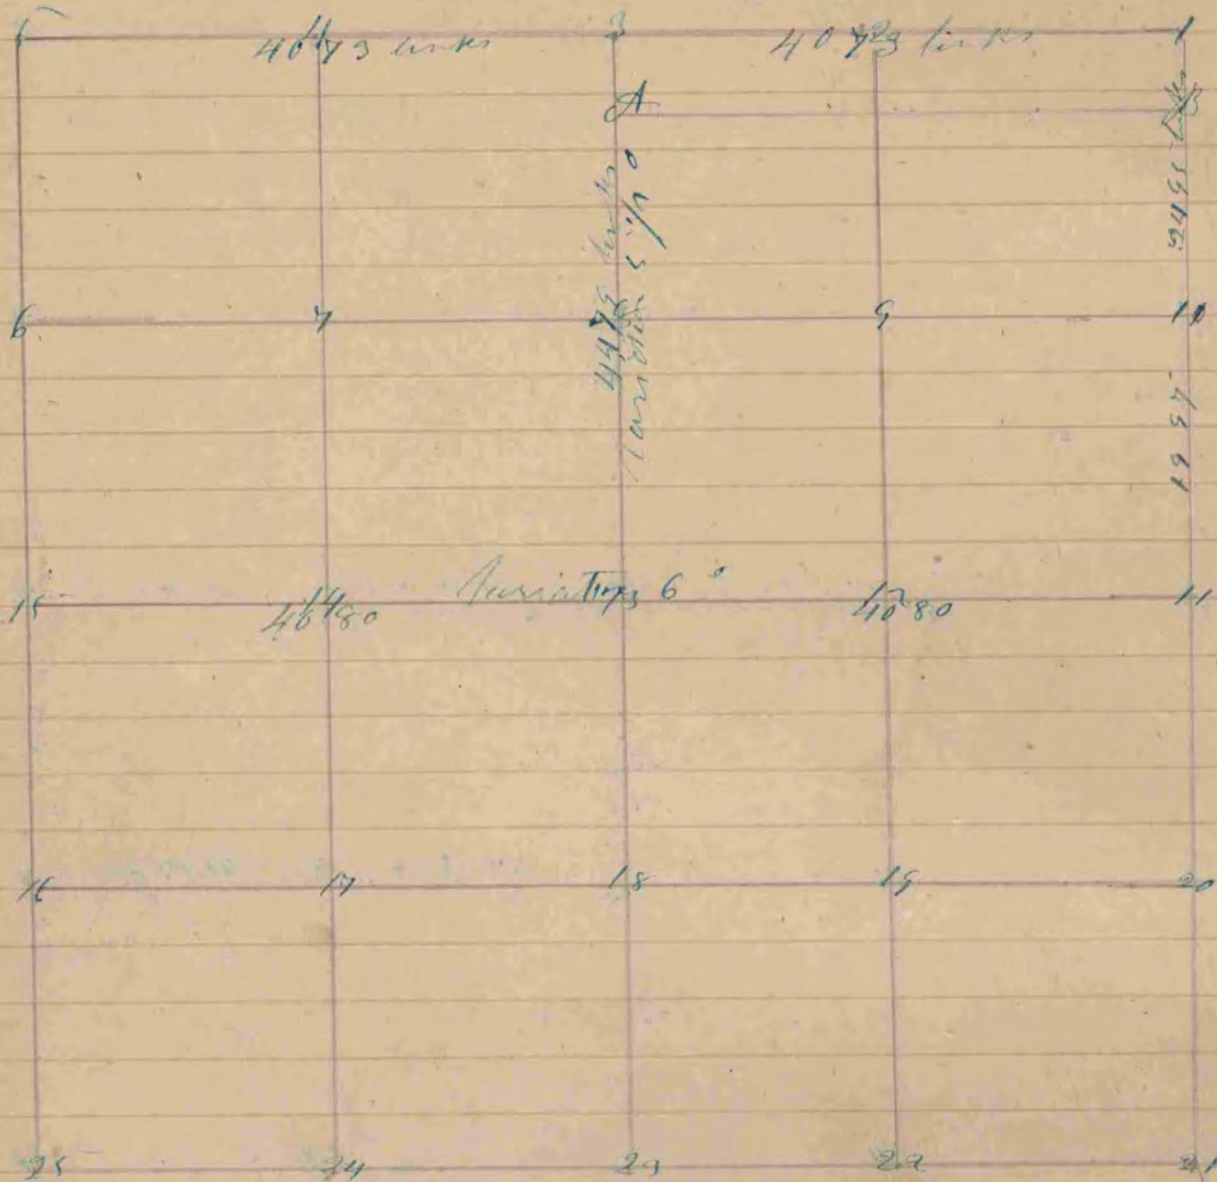


Fig 13 Stake marked no bearings

14 " " " "

21 " " " "

Let A & B Stake marked no bearings

The above Survey was made the Eleventh
day of June 1858 Beloit

Joseph Church County

Surveyor of Rock County 746

V