

A Record of a Survey of Section one in the Town of Johnston

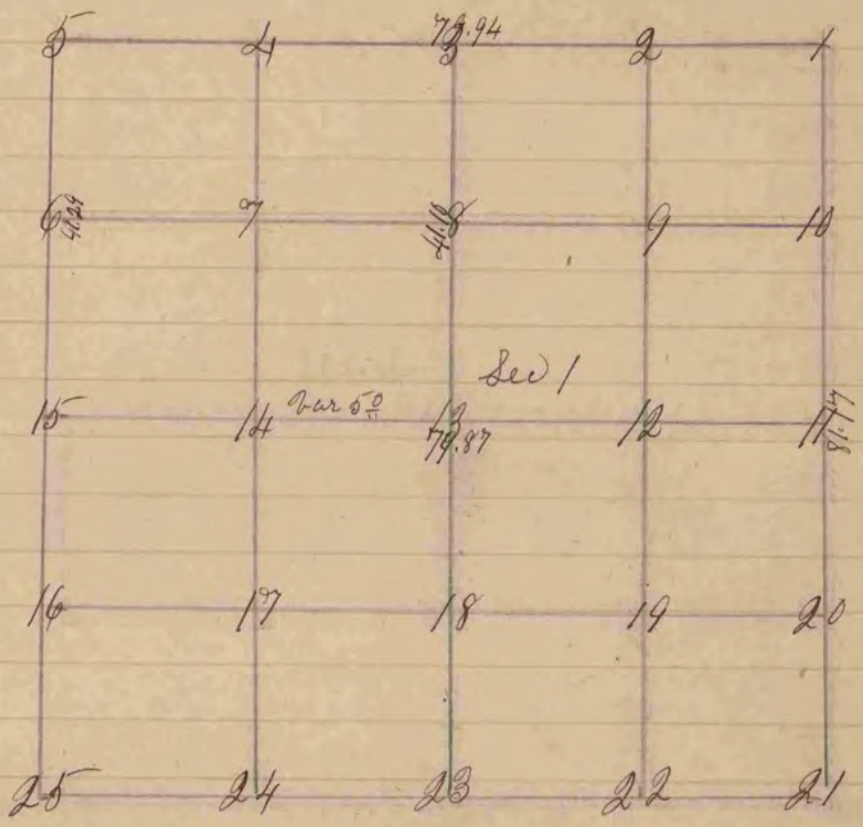


figure 13 represents the centre of the section
 fig 13. Br 0 14 N 110. also Br 0 10 N 63 W 37
 The above Survey was made February 19th 1852
 Peter M. Dean County Surveyor