



COUNTY SURVEYOR
RECORD 1 1851-1869

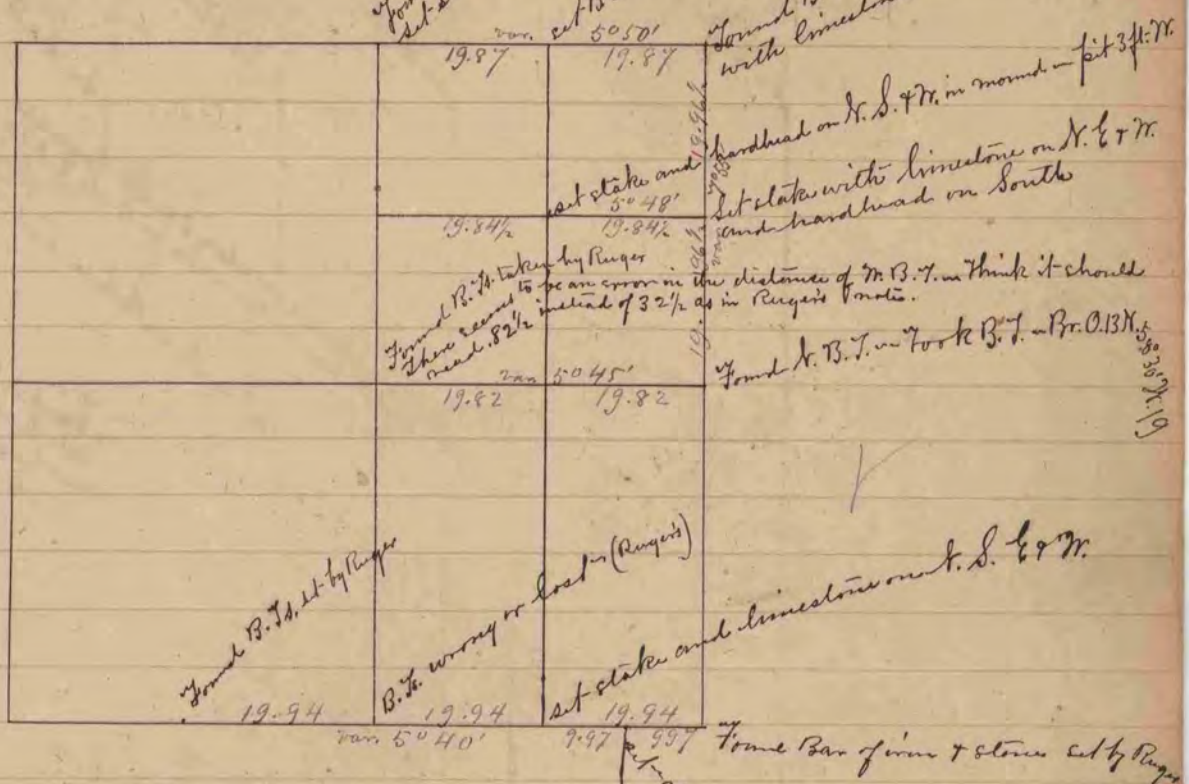

A Record & Plat of a Survey made on Sec. 24 T. 3 R. 13 E. June 2 & 3, 1864,
by L.D. Locke Co. Surveyor in and for Rock Co. Mis.

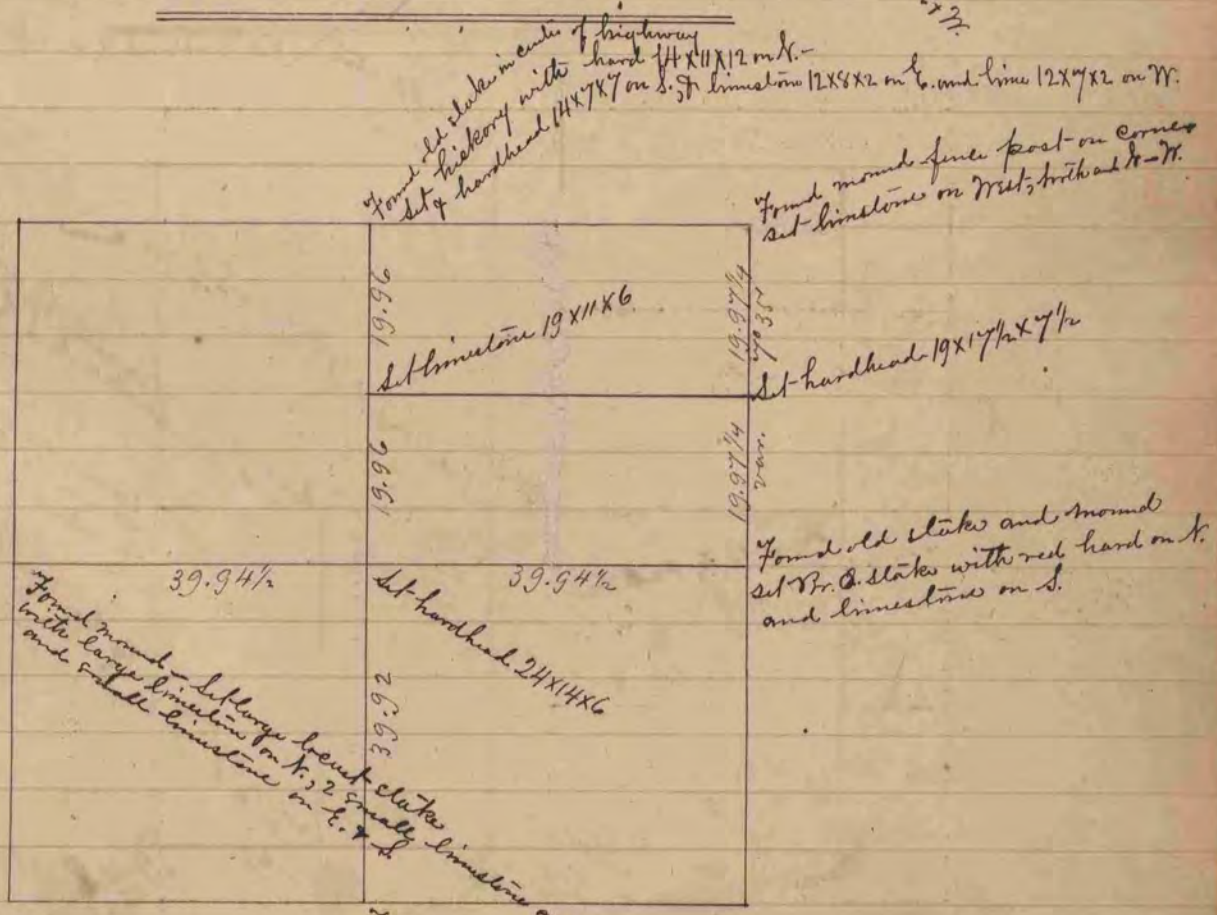

3. Record & Plat of a Survey made on
Sec. 27 T. 2 N. R. 13 E. June 4, 1864, by L.D. Locke
Co. Surveyor in and for Rock Co. Mis.