
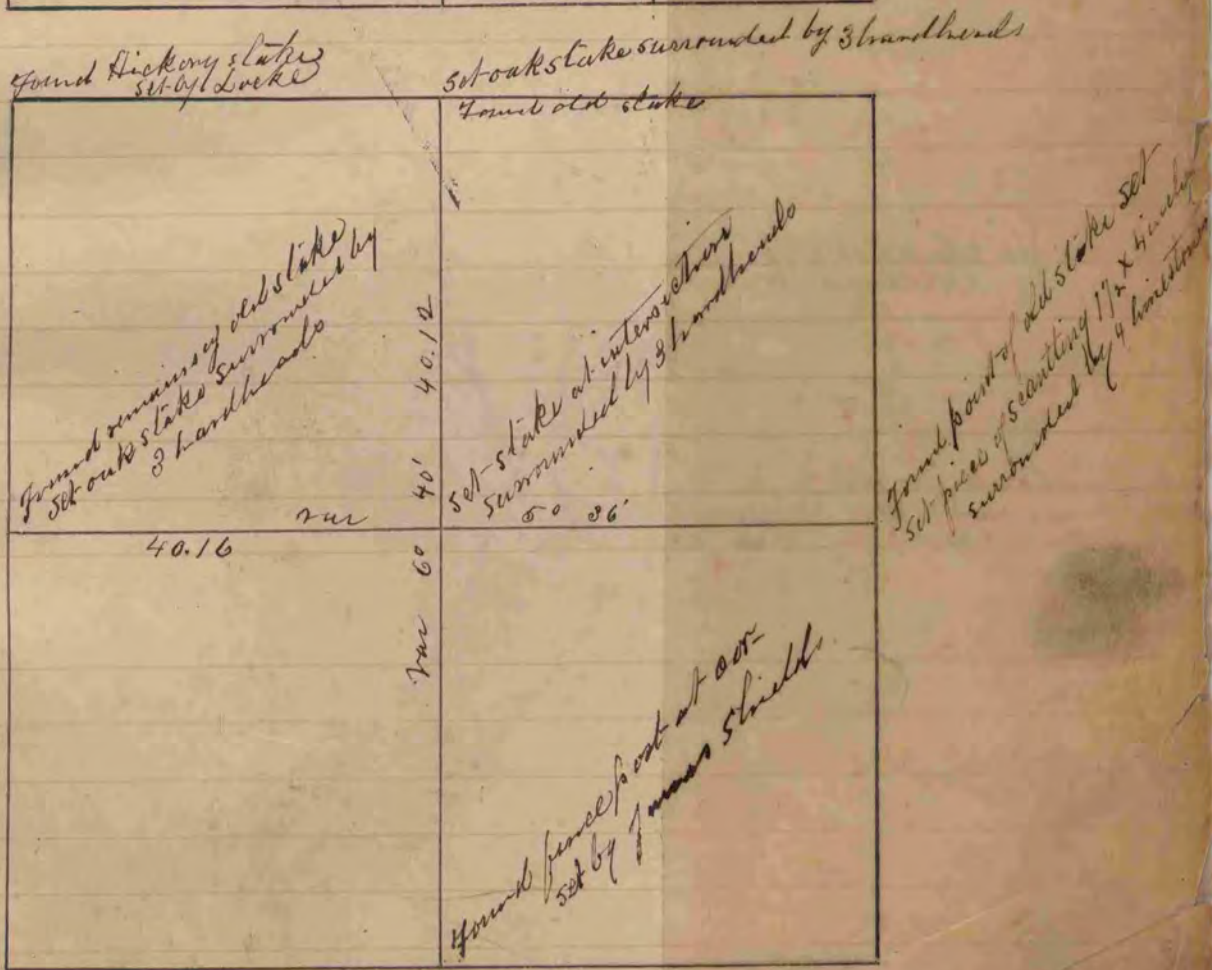


Below is a correct Record & Plat of a Survey made by me May 25 1869 on Sec. 8, T. 2 R. 12 (Rock)

R. K. Lee Dep. Co. Surveyor

COUNTY SURVEYOR  
RECORD 1 1851-1869

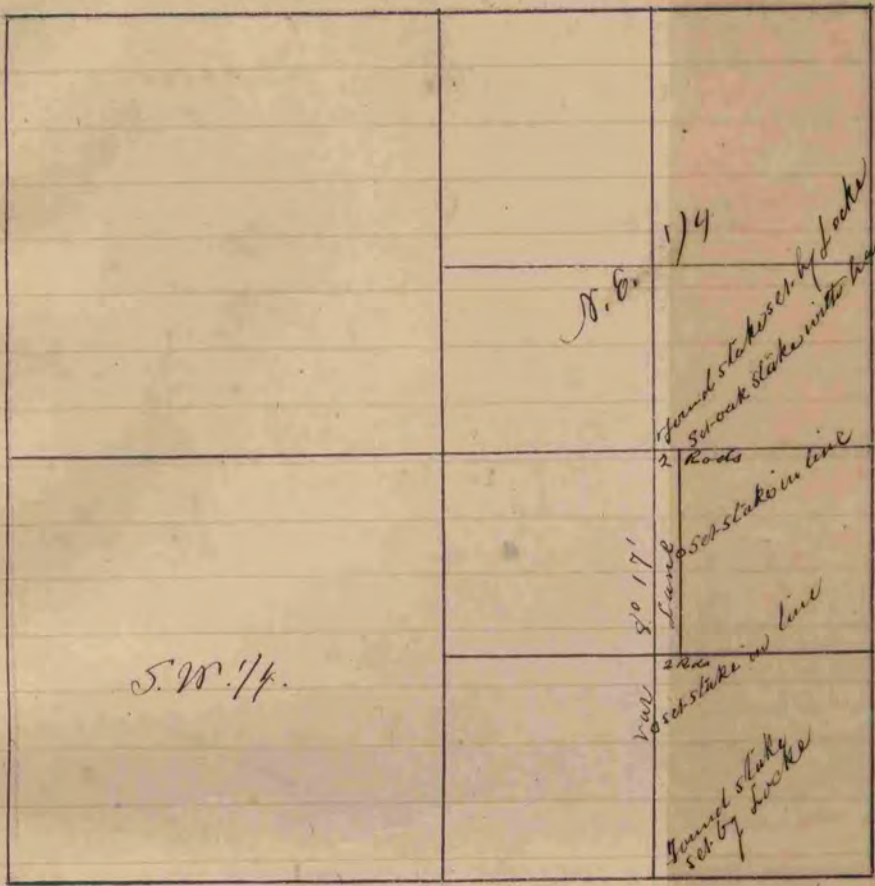

The above is a correct Record & Plat of a Survey made by June 10 1869 on Sec. 13, T. 2 R. 12 (Rock) R. K. Lee Dep. Co. Surveyor