
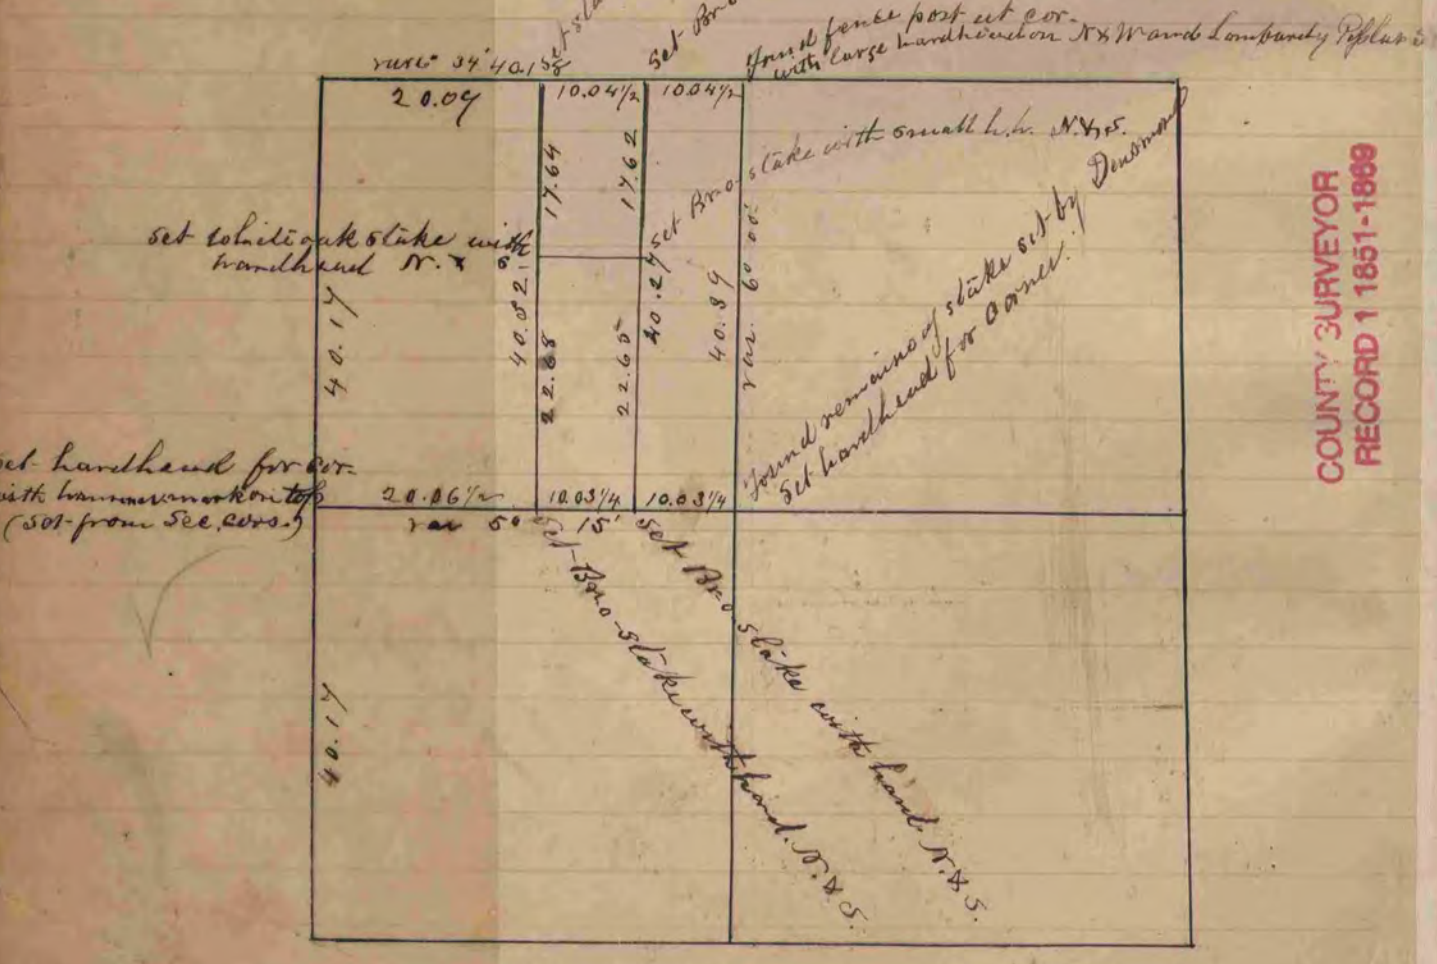


Below is a correct Record & Plat of a Survey made by me June 8th 1869 on Sec. 5 T. 1. R. 14 (Clinton)

R. H. Lee Dep. Co. Sur

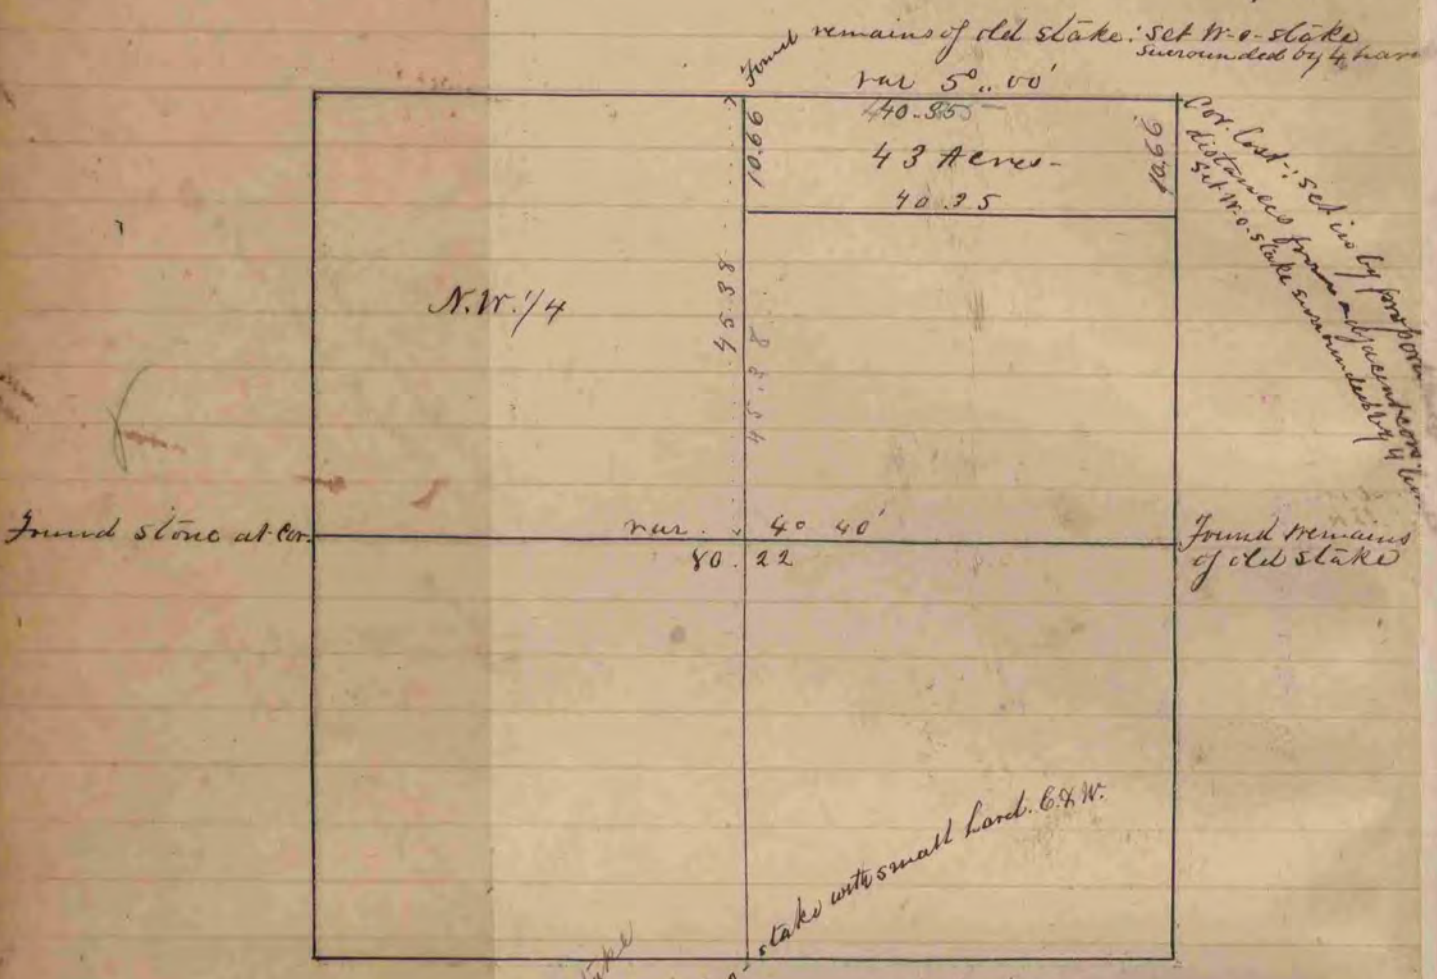

COUNTY SURVEYOR
RECORD 1 1851-1869

The above is a correct Record & Plat of a Survey made by me June 9th & 10th 1869 on Sec. 33 T. 2. R. 14 (Burdick)

R. H. Lee, Dep. Co. Surveyor