

A plat of a survey made on section twenty five in the Town of
Avon, Town one Range ten

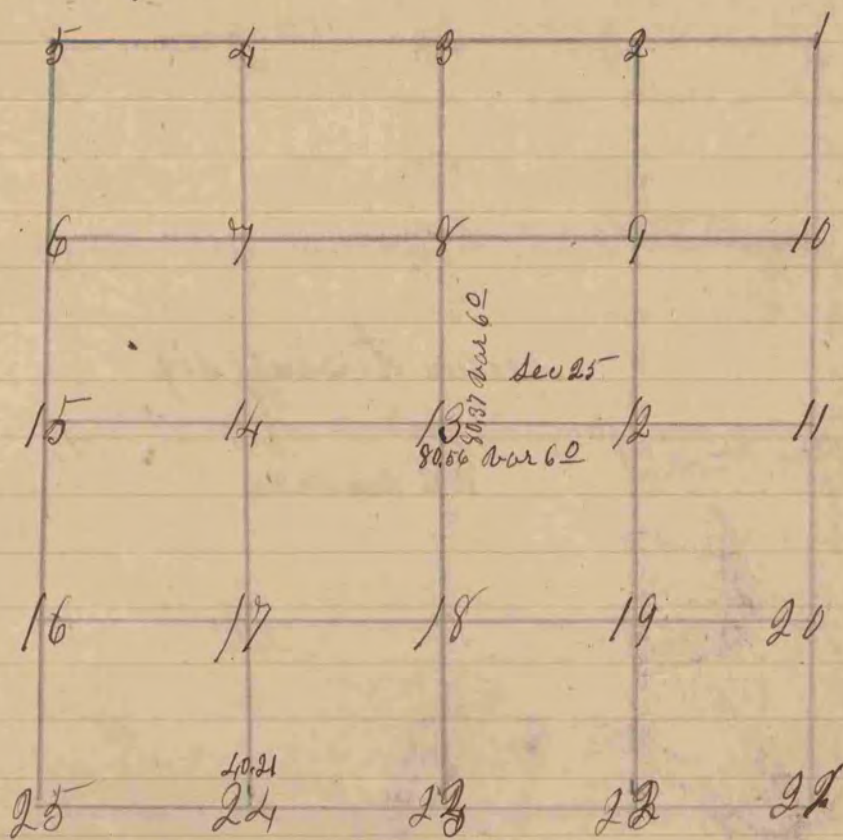


figure 13 represents the centre of the section

fig 13 Br 0 12 N 9 1/2 W 29 also Br 0 10 N 65 1/2 W 36

The above survey was made June 6th 1864

Peter M. Bean County Surveyor