


The above is a correct record and plat of a survey made by me June 28 & 29, 1867, on Sec. 13, T. 14, R. 14, Clinton R. K. See Deputy Co. Surveyor

Found stakes set by Raper

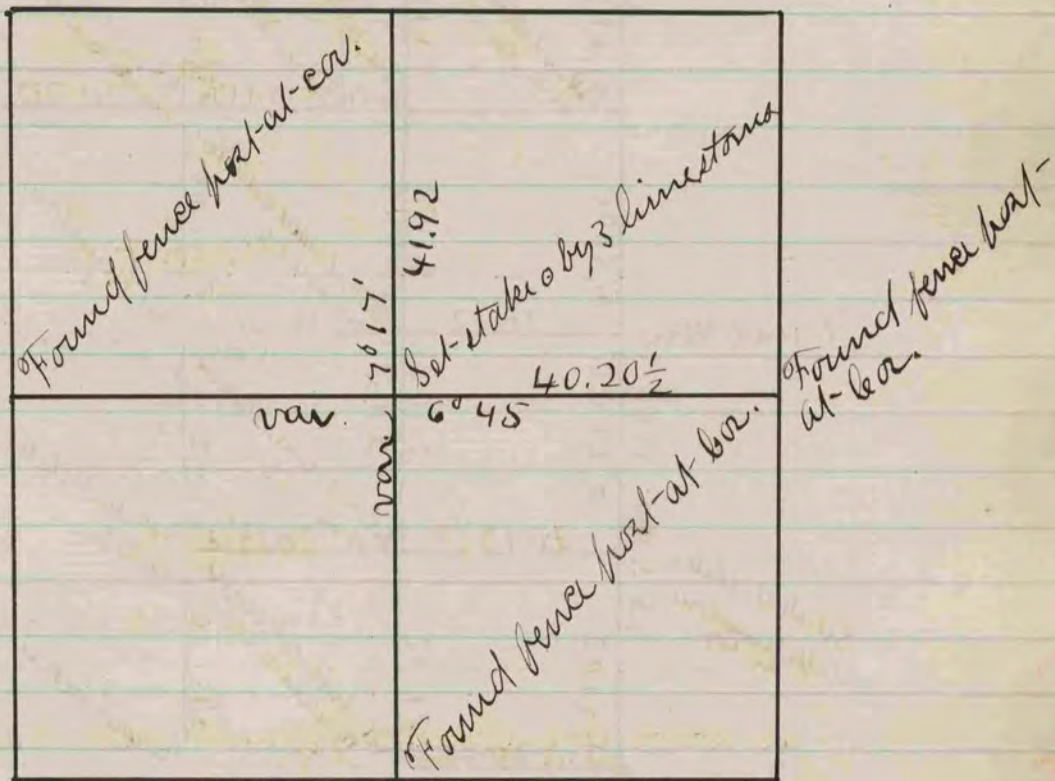

The above is a correct record and plat of a survey made by me July 20, 1867, on Sec. 5, T. 2, R. 12, Roets

R. K. See
Deputy Co. Surveyor

COUNTY SURVEYOR
RECORD 1859-1906