


Record & plat of a survey made on Sec twenty two
town two Range ten East

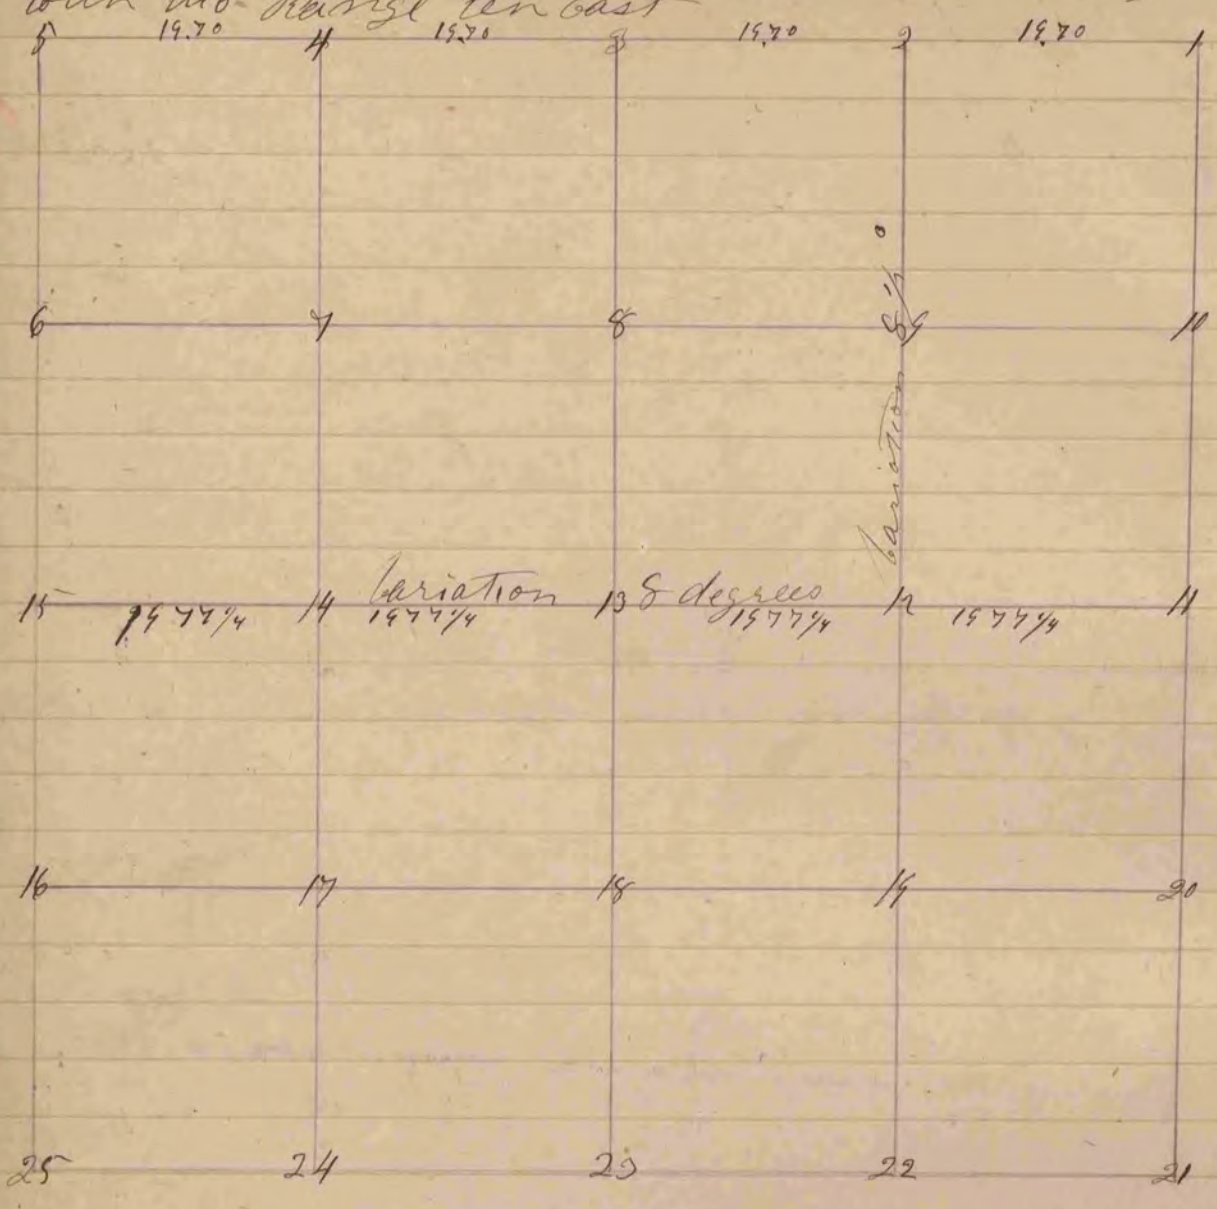

- Fig 12 Stamp ten inches N 41/4 E 9 1/2 links
 " " " " S 22 1/4 W 40 "
 " 13 " W 0 12 " N 76 W 10 8 "
 " " " 12 " N 60 E 140 "
 " 14 " W 0 20 " N 31 1/2 W 36 "
 Stamp " " S 11 1/2 W 11 1/2 "

The above survey was made April first
 eighteen hundred & fifty seven
 Joseph Church by Charles H Brown
 Deputy County Surveyor of Rock County
 W.H.