



207

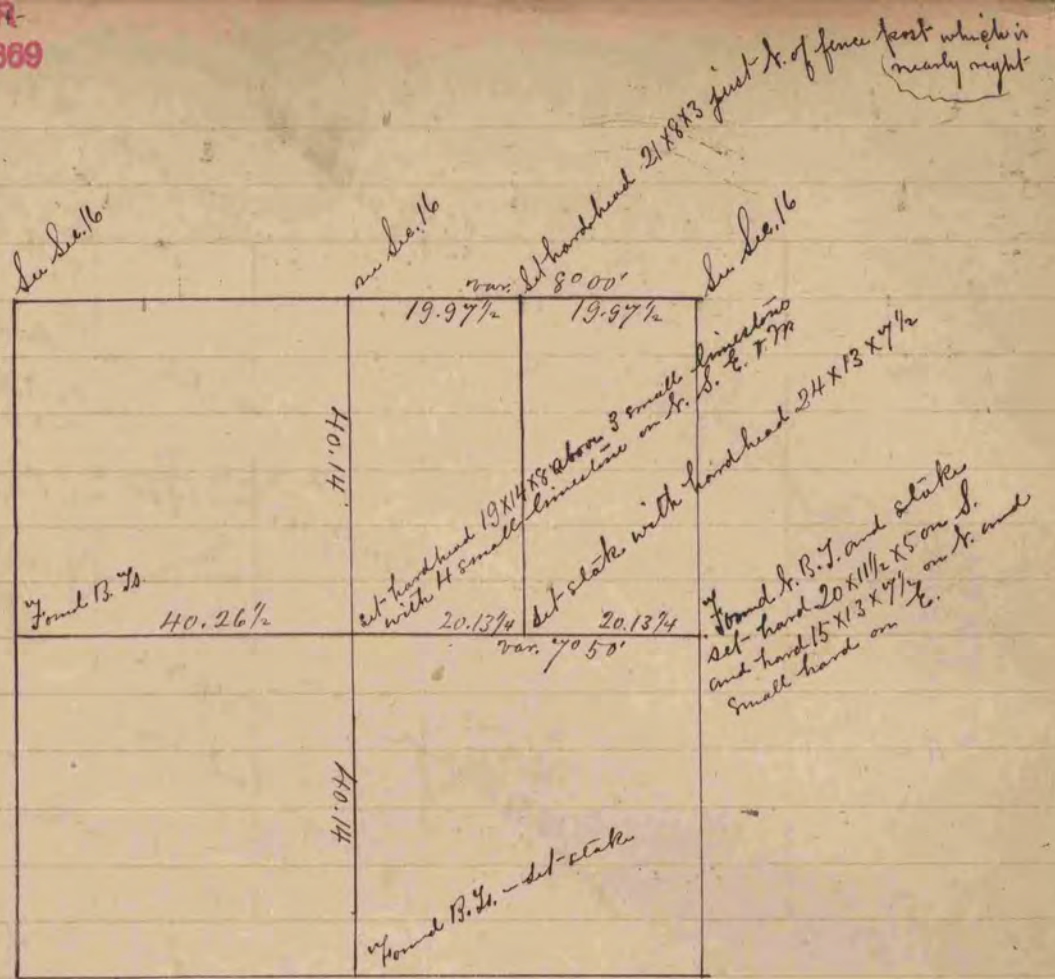

A Record & Plat of a Survey made on Sec. 21 T. 4 N. R. 11 E.
June 7th 1864 by S. D. Locke Co. Surveyor. in and for Rock
Co. Wis. - P. Porter

Found old stakes - set hardhead 16x16x8

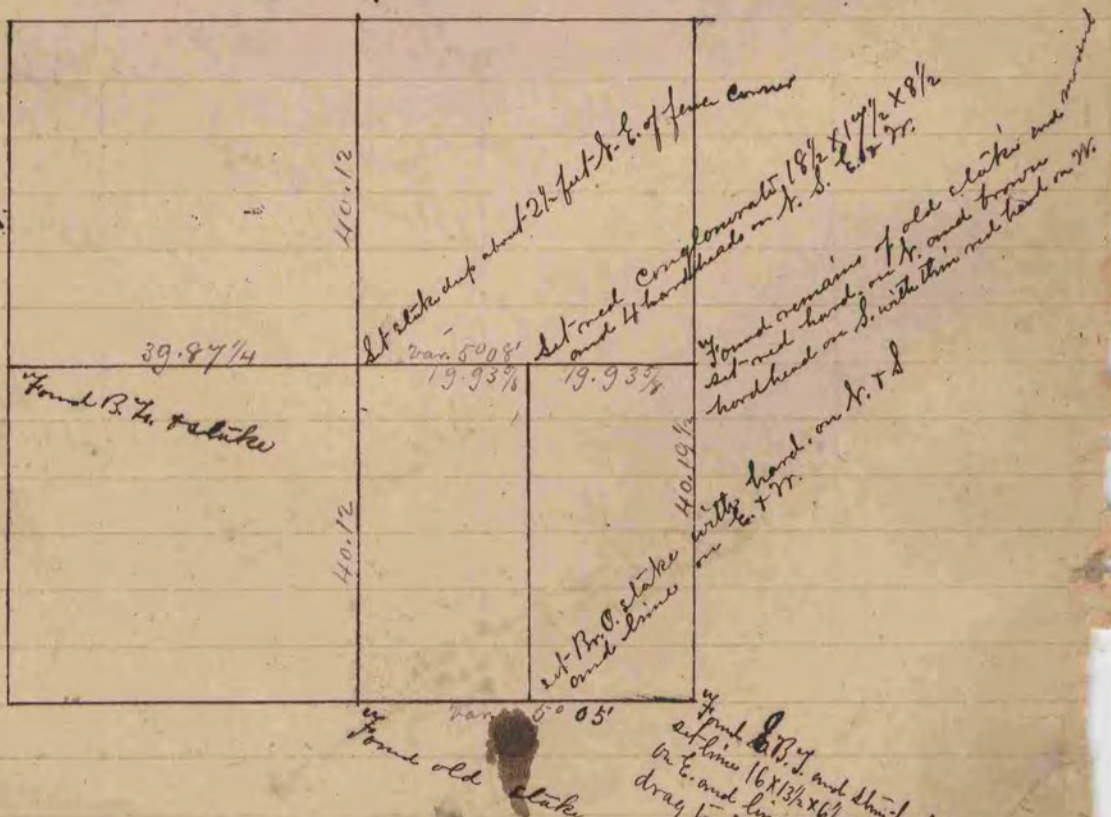

A Record & Plat of a Survey made on Sec. 33 T. 4 N. R. 13 E.
June 20 & 21 - 1864, by S. D. Locke Co. Surveyor. in and for Rock Co. Wis.
Millon