



Below is a correct Record & Plat of a survey made by me April 12th & 13th 1869 on Sec. 6, T. 3 R. 12 (Janesville)

R. K. Lee, Dep. Co. Surveyor

Found stumps of B.S.S. & old stake under fence

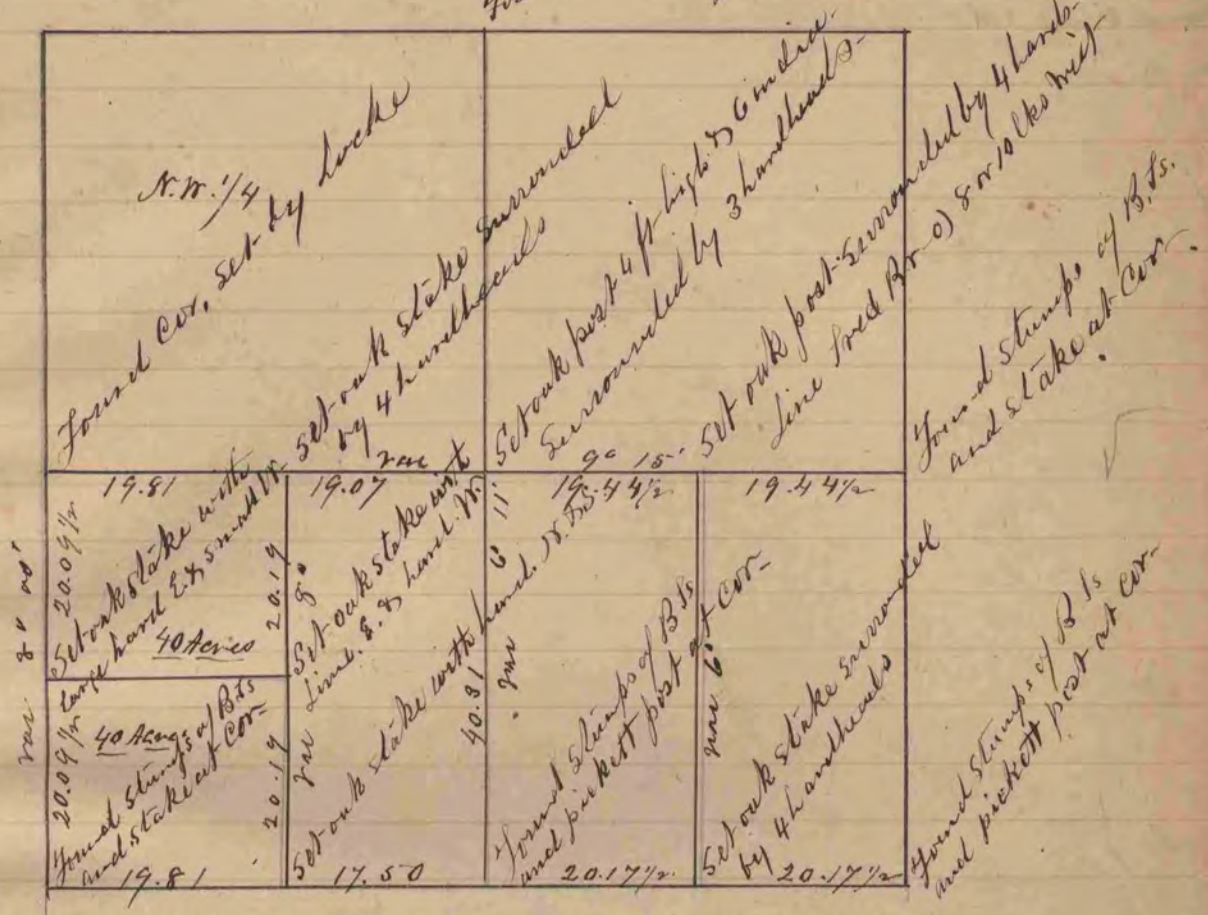

Found stake set by Rugeo

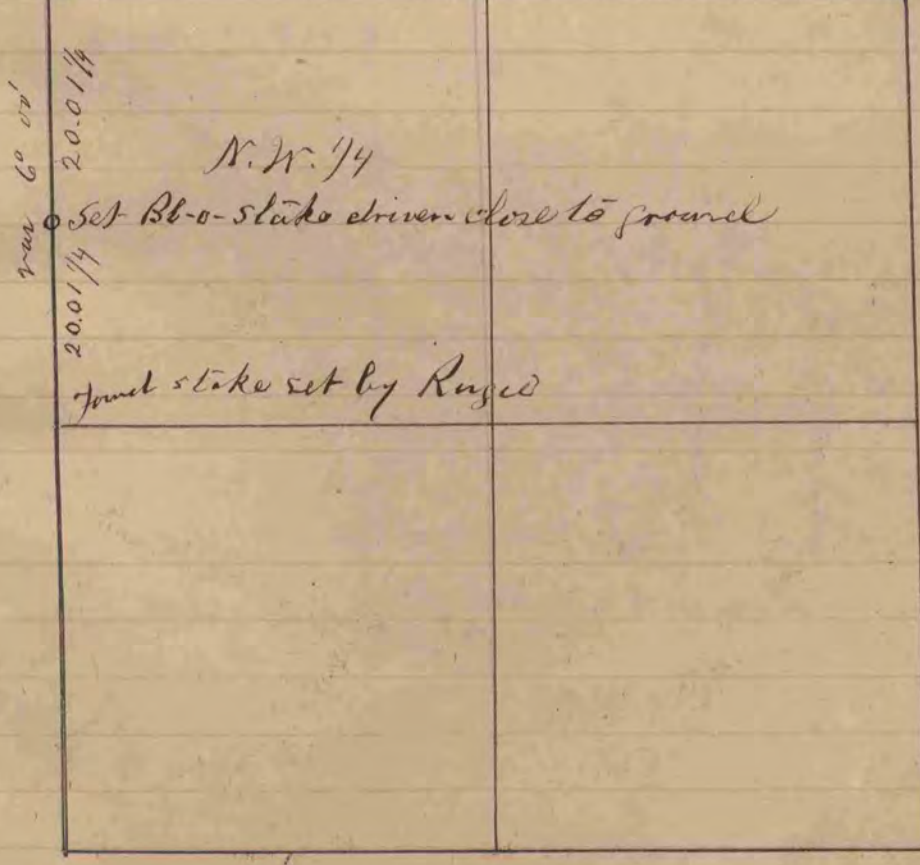

COUNTY SURVEYOR
RECORD 1 1851-1869

The above is a correct Record & Plat of a Survey made by me April 13th 1869 on Sec. 16, Harmony.

R. K. Lee, Dep. Co. Surveyor