



Found old stake & found decayed stump of both B. & S. - drove new stake in the place of the old one & @ it by 4 H. H. do.

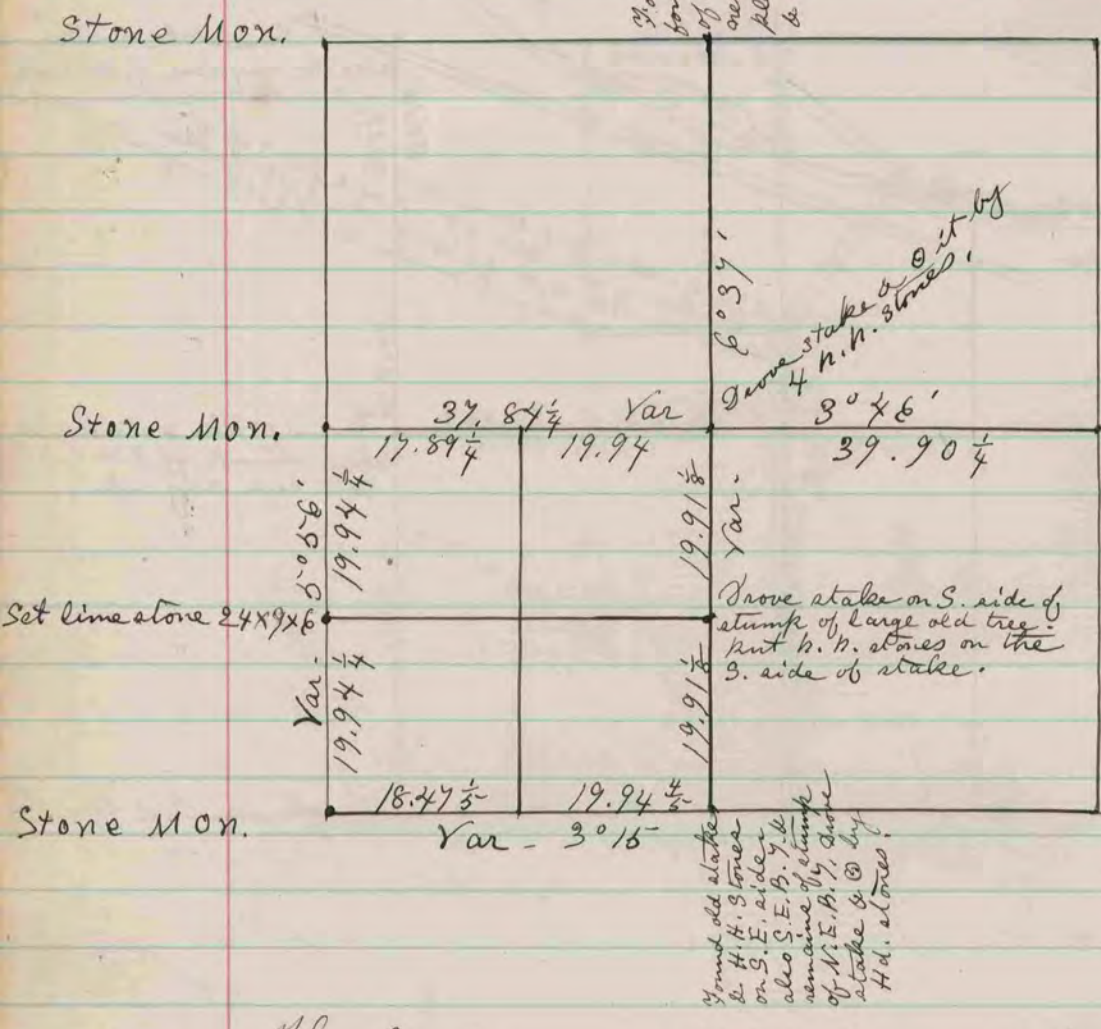

The above is a record & plat of a Survey made by me on Sec 7 Johnstown May 3 & 4th 1883
Edward Ruger Co. Surveyor.

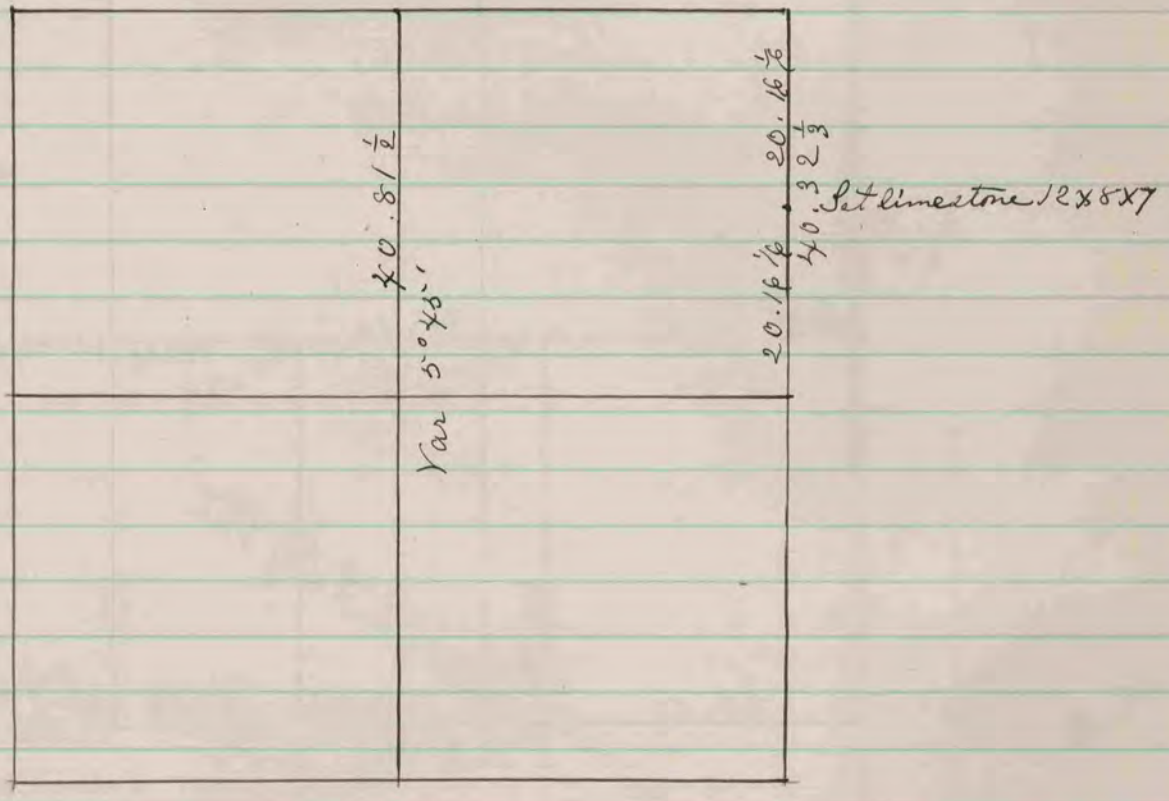

The above is a record & plat of a Survey made by me on Sec. 6 La Prairie.