


The above is a correct Record & Plat of a Survey made
by me Oct. 9 1866 on Sec. 3. Town of Clinton
S. D. Locke Co. Surveyor

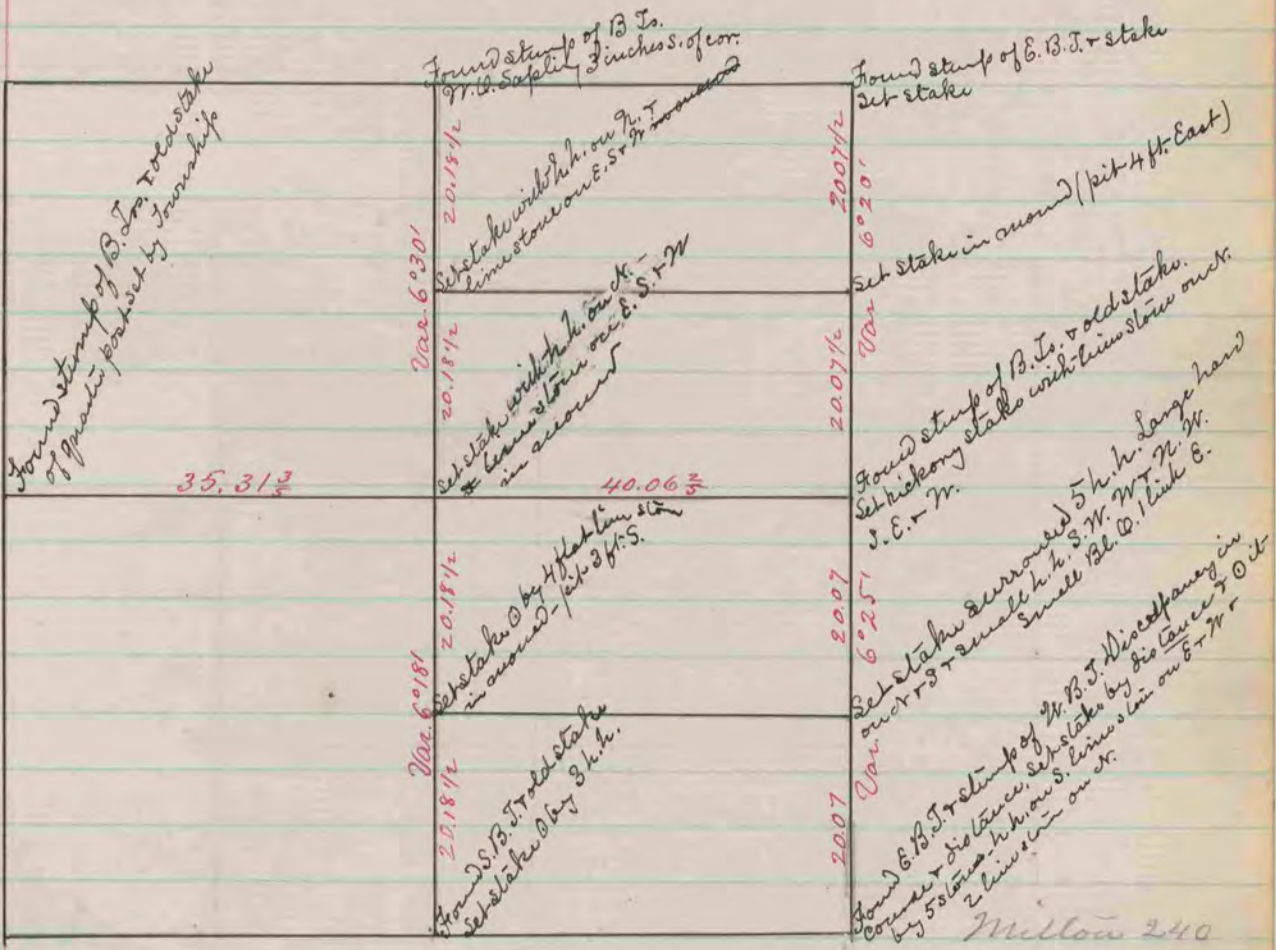

The above is a correct Record & Plat of a Survey
made by me Nov. 14 & 15, 1866, on Sec. 19. Town of Milton
S. D. Locke Surveyor Rock, Co.