



West line of S.W. 1/4 of Sec. 23 Rock.

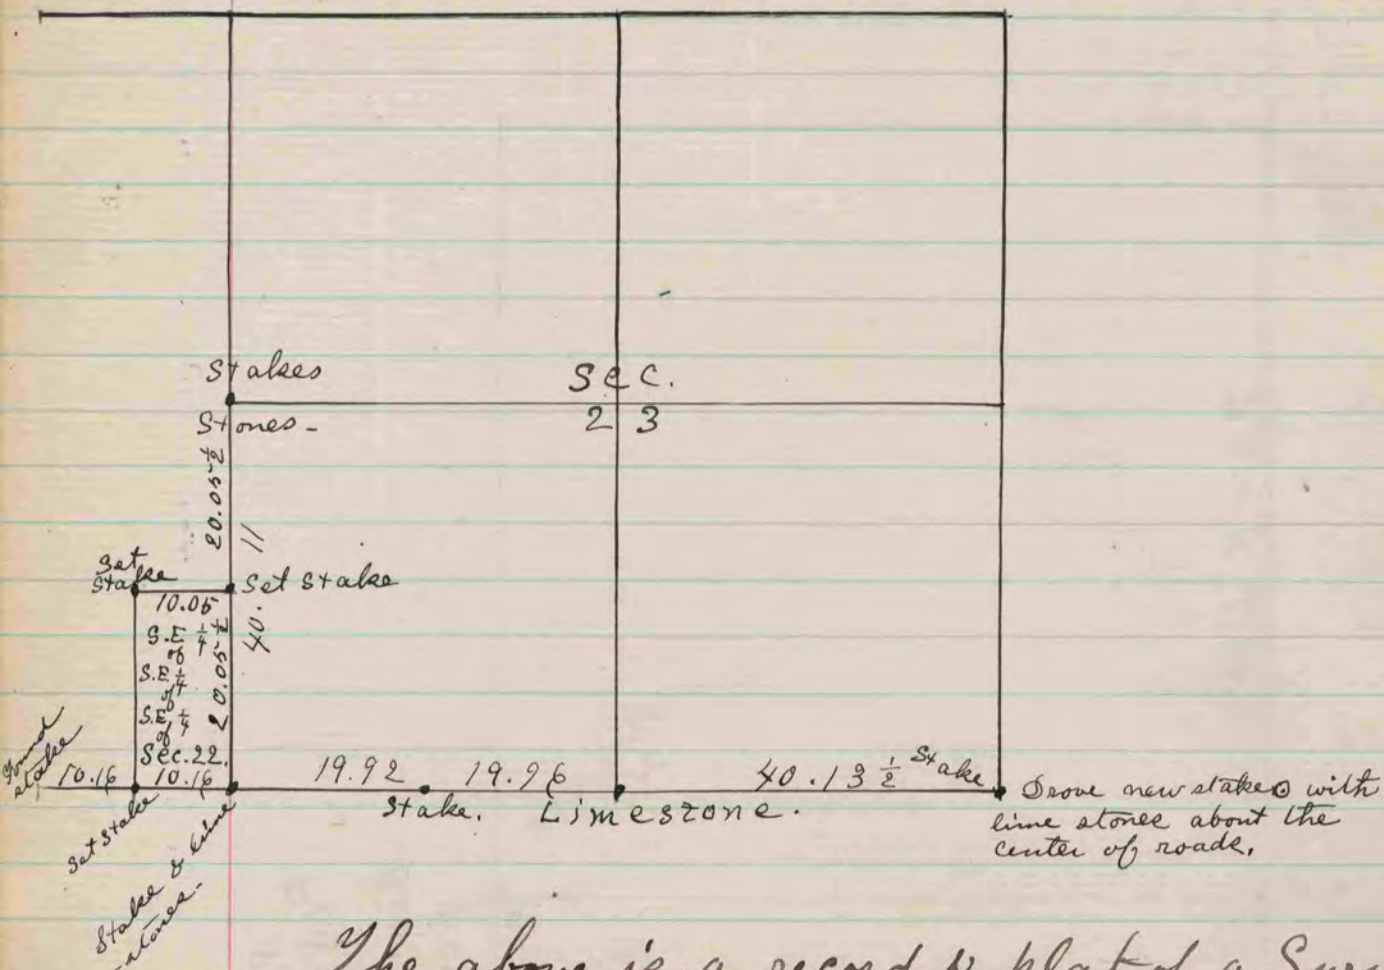

The above is a record & plat of a Survey made by me on Sections 22 & 23 Rock Dec 6<sup>th</sup> 1881

J. A. Holmes  
Co. Surveyor

N.E. 1/4 of Sec 11 Rock.

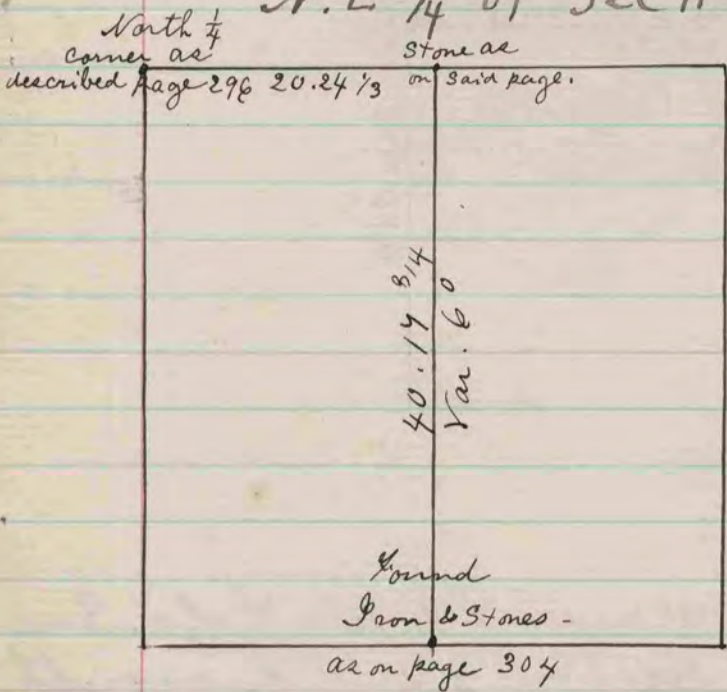

The above is a record & plat of a Survey made by me on Sec. 11 Rock - December 7<sup>th</sup> 1881

J. A. Holmes  
Co. Surveyor.