


The above is a record & plat of a survey made by me March 5 & 8, 1870 on Sec. 11. Rock Edward Ruger. Dep. Co. Surveyor.

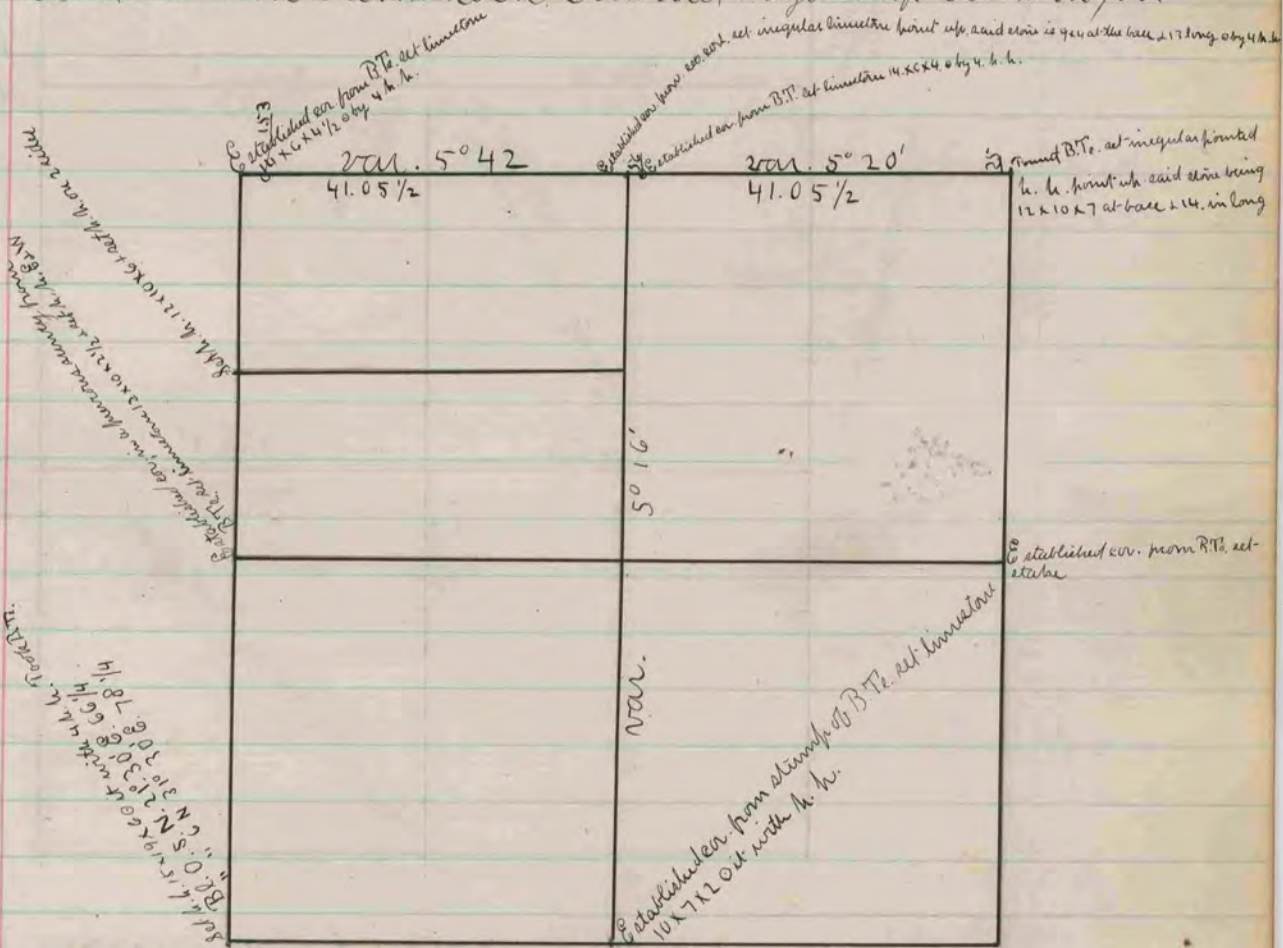

The above is a plat & record of a survey made by me on Sec. 3 Lima. March 9 & 10, 1870.

Edward Ruger  
Dep. Co. Surveyor.

COUNTY SURVEYOR  
RECORD 1859-1906