


The above is a correct Record & Plat of a survey made by me
Dec. 6, 1865, on Section 31 - Harmony - S.E. 1/4 of the Sec -
S.H. Locke Co. Surveyor

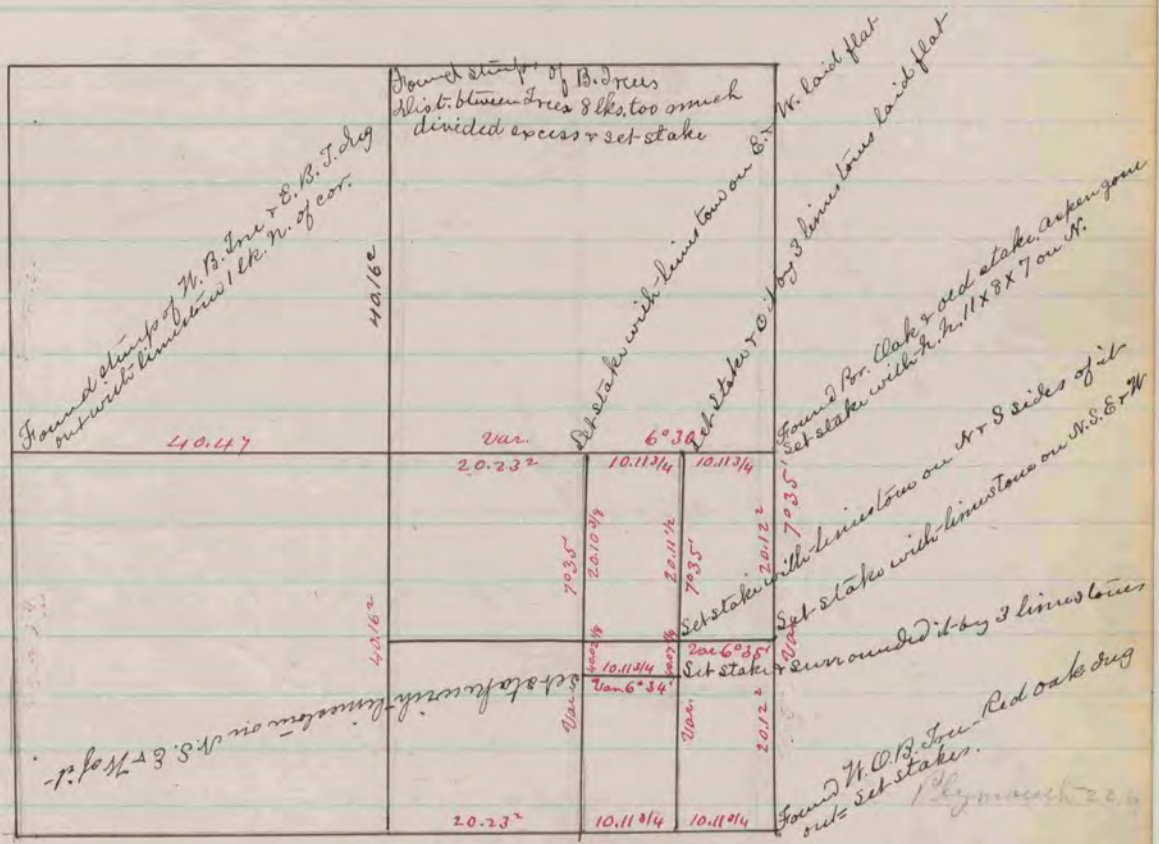

The above is a correct record & plat of a survey
made by me Dec. 8 & 9, 1865 on Sec. 26 Plymouth
S.H. Locke Co. Surveyor.

COUNTY SURVEYOR
RECORD 1859-1906