

of record and plat of a survey made on Sec 3 Town 1 Range 14 East

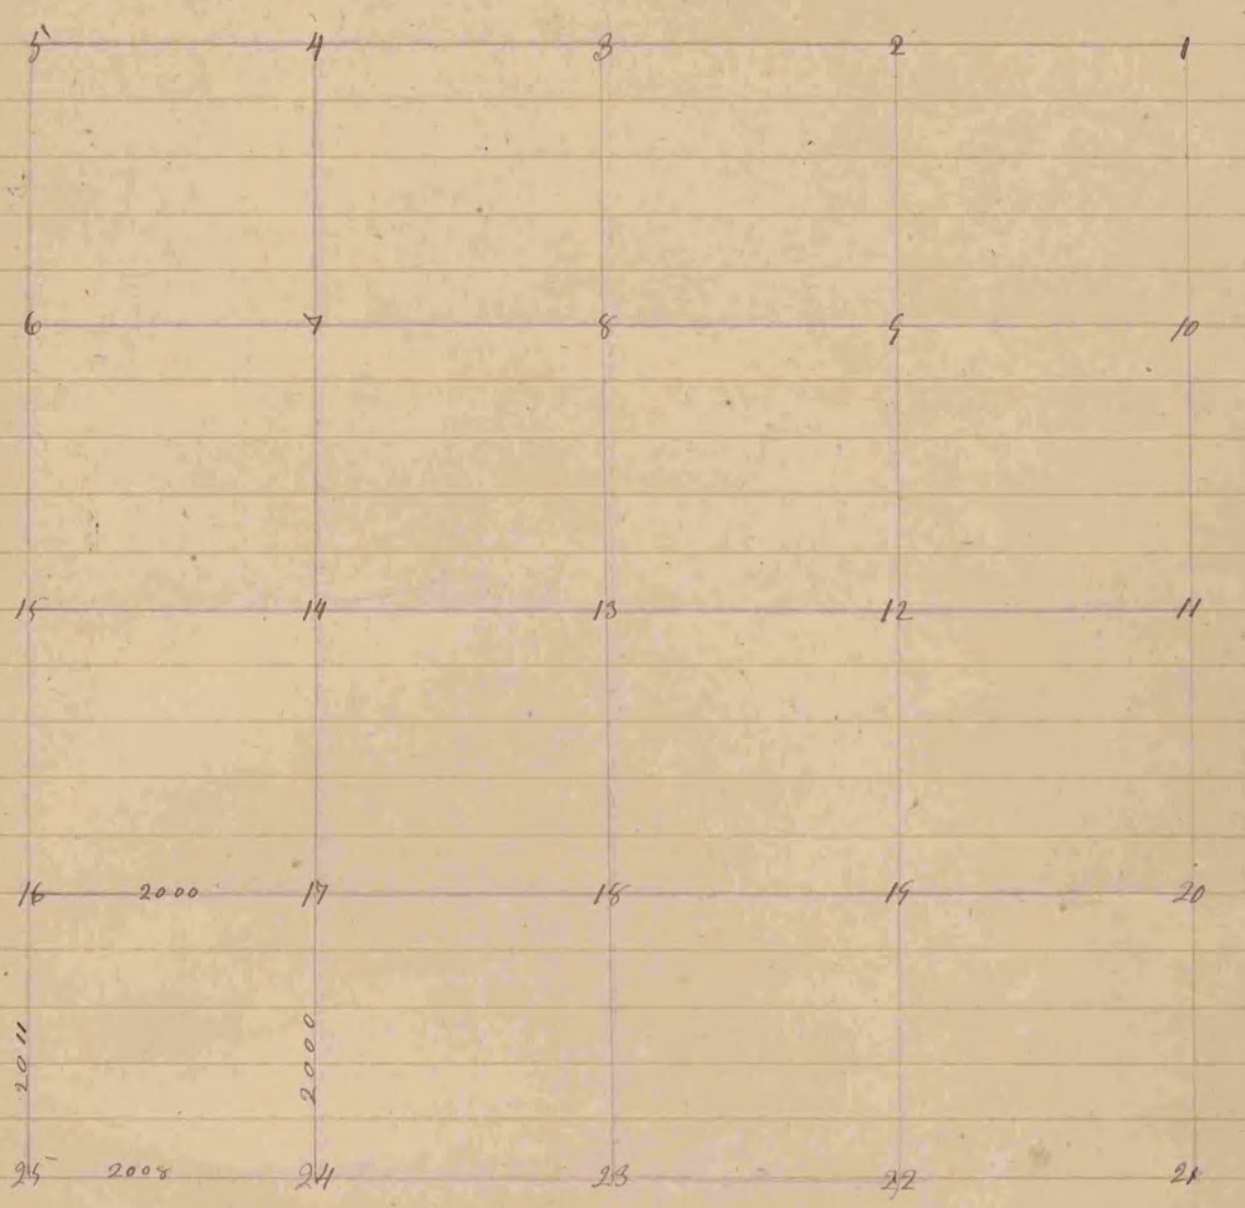


Fig 16 17 24 & 25 Stake and Stones fixed in the ground
 16 & 25 is 50 links east of the Centre of the high way
 The above survey was made Sept 20th 1855

Joseph Church County Surveyor
 Beck County Mo