


Set these lime stones  
surrounded with  
lime stones

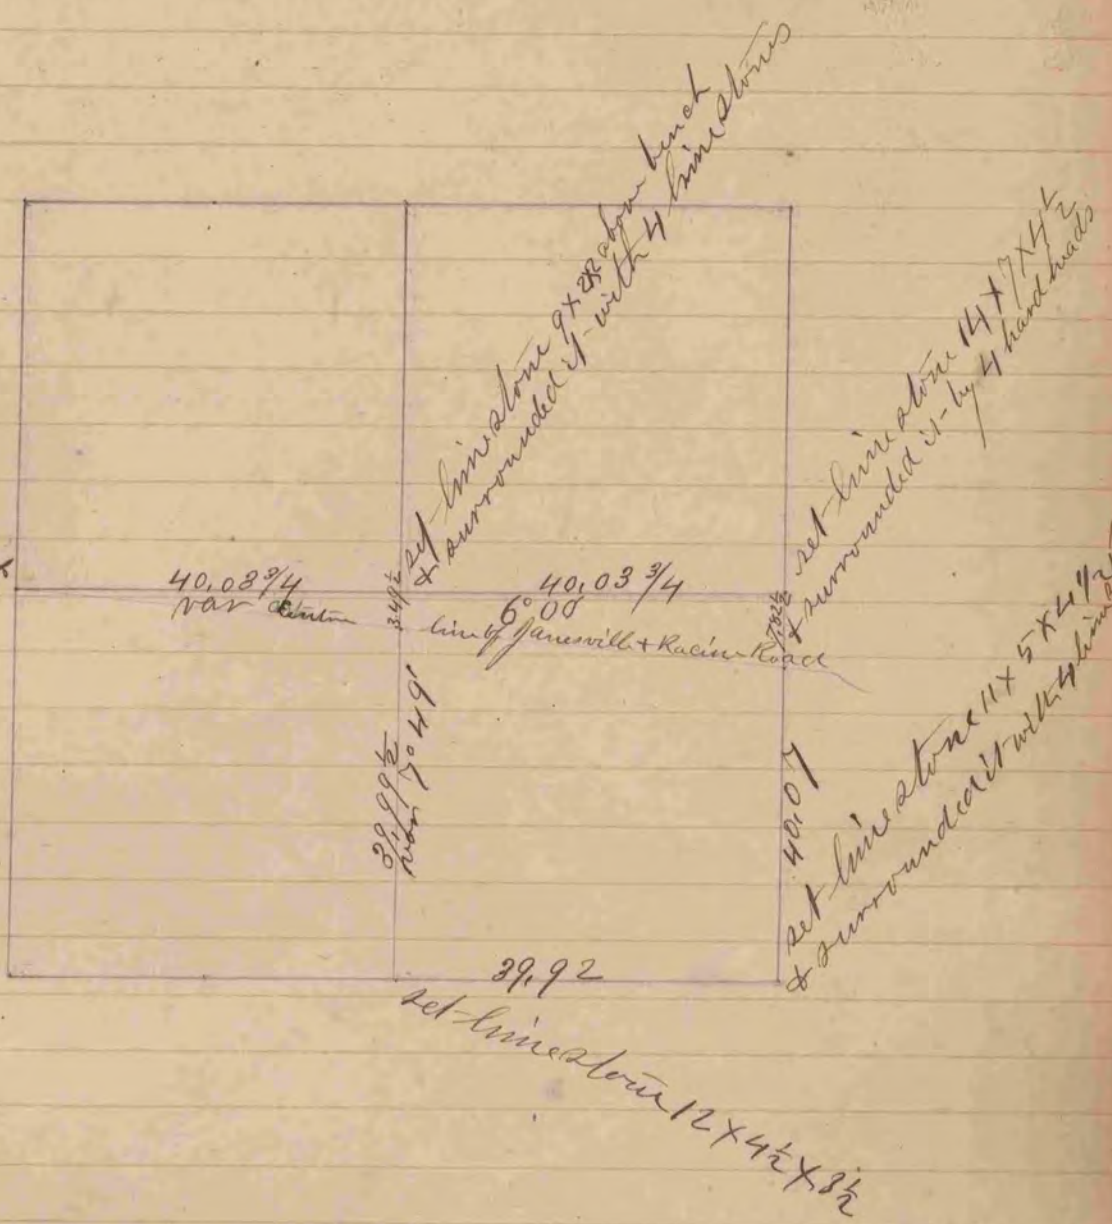

A record and plat of a survey made on Dec  
3<sup>rd</sup> 1860 by Edward Rugey  
County surveyor for Rock County  
La Prairie