


The above is a correct Record & Plat of a Survey made by me
 Oct. 8, 1867, on Sec. 6, Plymouth, S. D. Locke, County Surveyor in & for Rock Co.

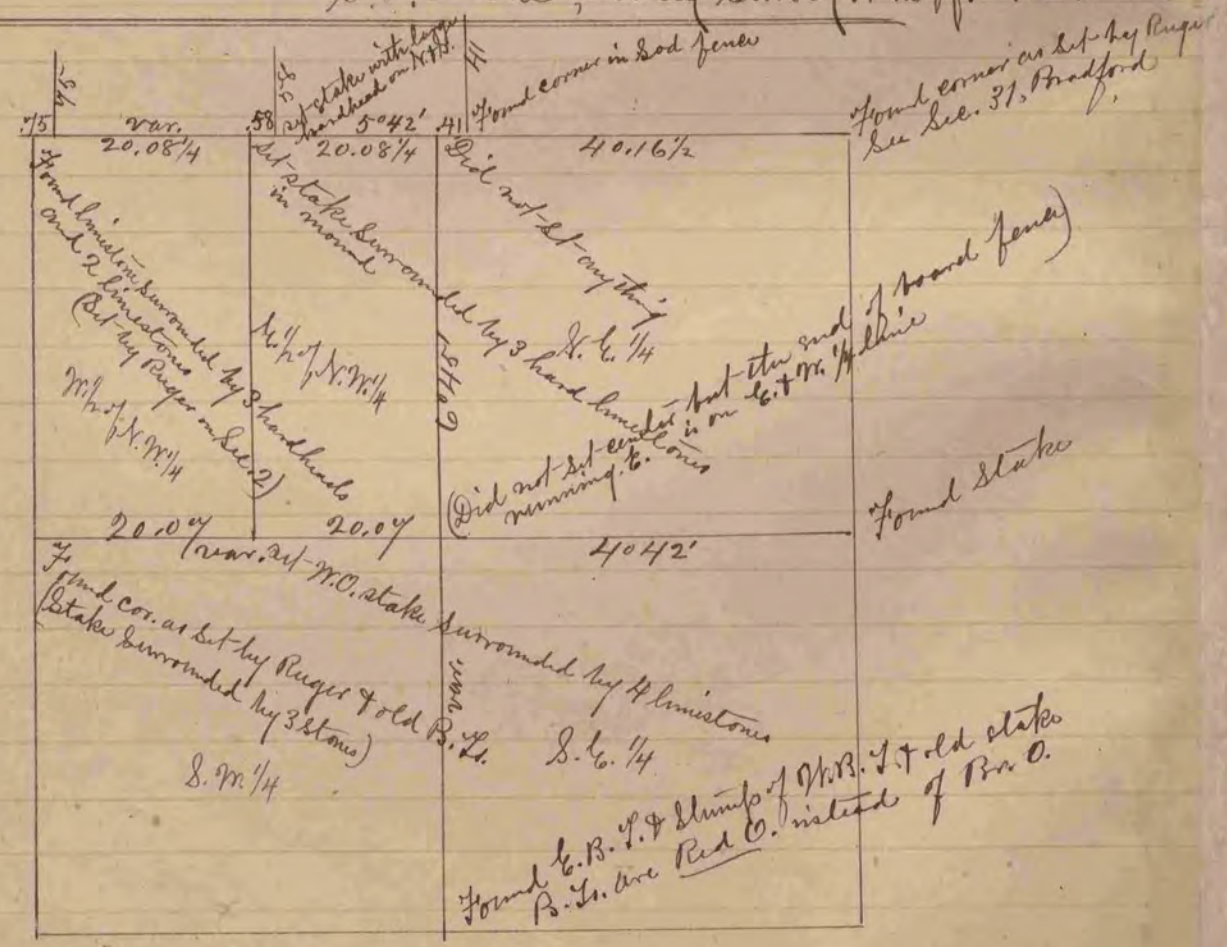

The above is a correct Record & Plat of a Survey made by me
 Oct. 10, 1867, on Sec. 1, North, S. D. Locke County Surveyor in & for Rock Co. Miss.