


Found Stump of S.B. 1/4 old stake
set Por. O. stake with hardwood
on N. 1/4 S. 1/4 limestone on E. 1/4

The above is a correct Record & Plat of a Survey made by me
Nov. 15, 1867, on Sec. 32, Union.

S.D. Locke, County Surveyor in and for Rock Co. Wis.

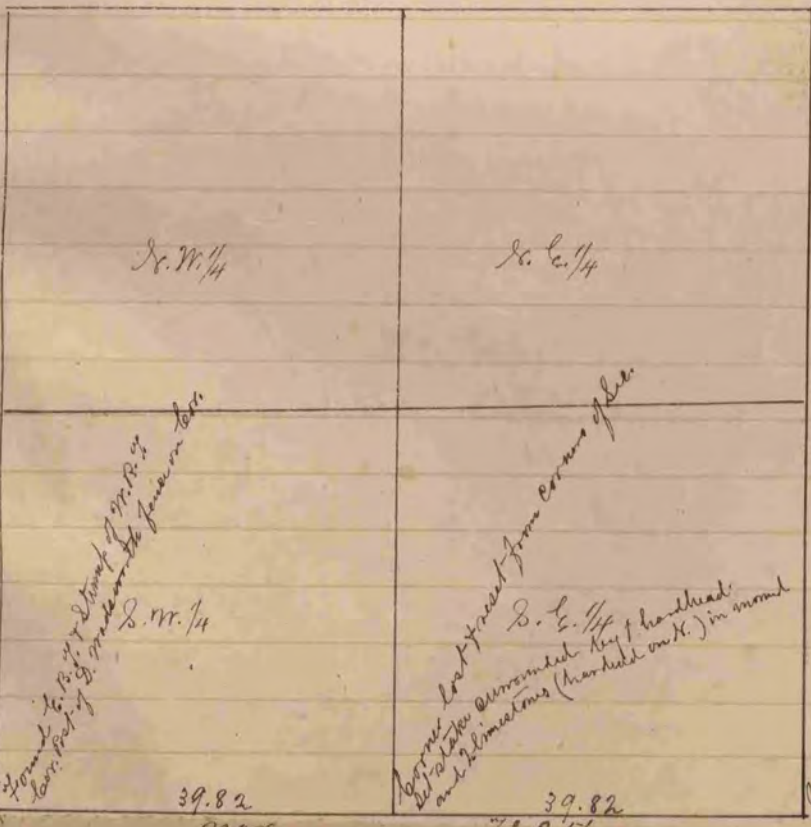

Set stakes in mound

The above is a correct Records & Plat of a Survey made by
Nov. 14+15, 1867, on Sec. 35, Union.

S.D. Locke County Surveyor in &
for Rock Co. Wis.