
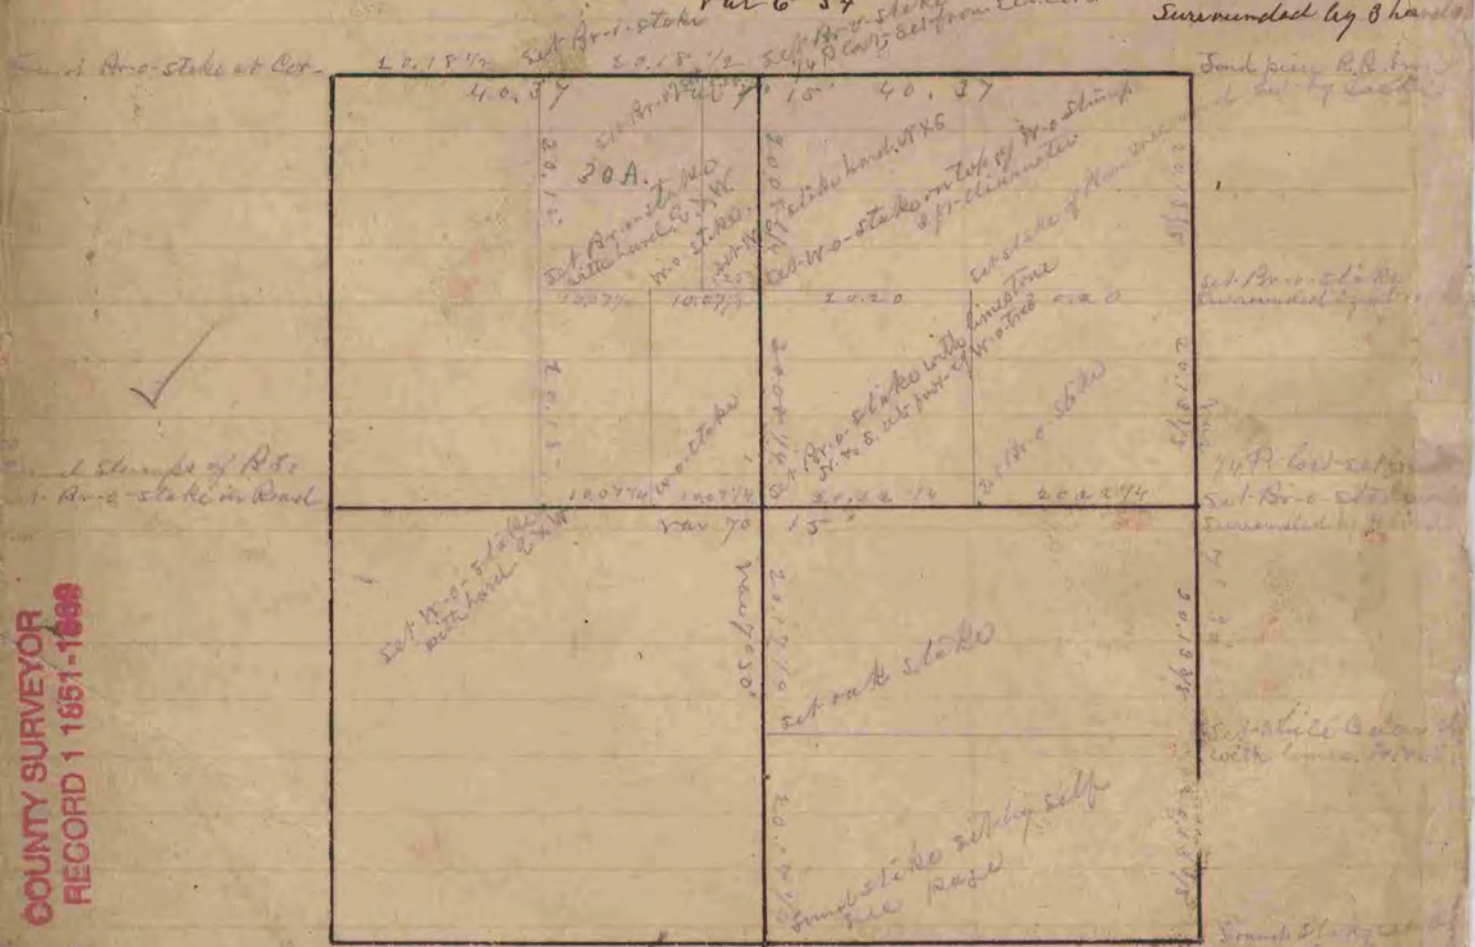


Below is a correct Record & Plat of a Survey made by me (Prolix)
 on Sec. 2, T. 3, R. 11 (Center) Oct 8 to 10th 1869

R. H. Lee Dep. Co. Surveyor

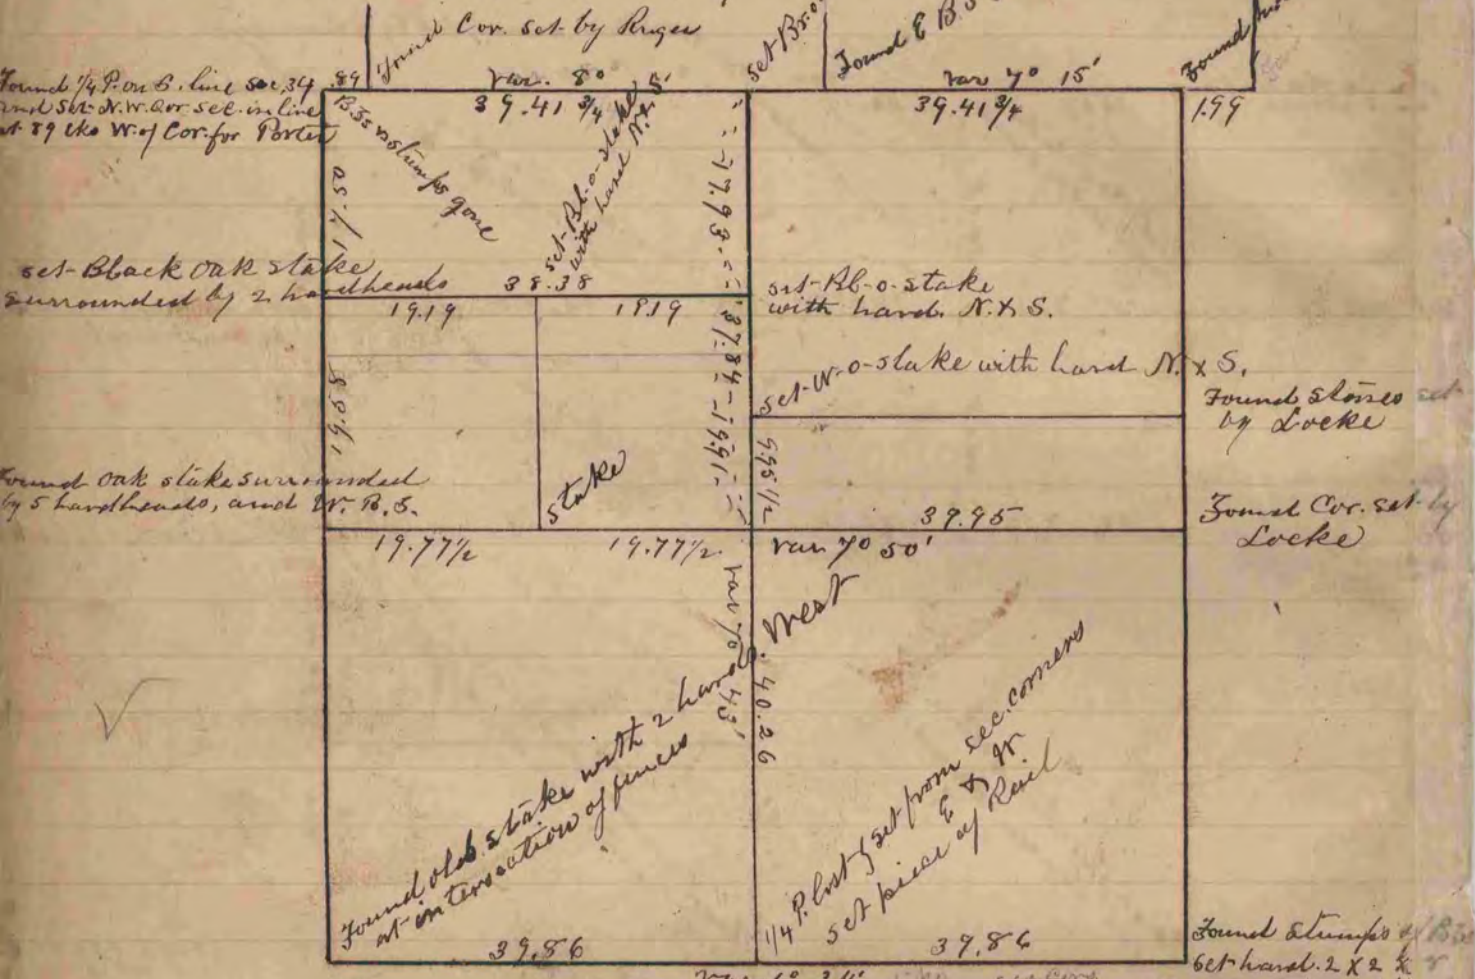

The above is a correct Record & Plat of a Survey made by me
 Oct 21st 1869 on Sec. 22 T 10 R 10 Magnolia

R. H. Lee Dep. Co. Surveyor

COUNTY SURVEYOR
 RECORD 1 1861-1869