



ROYAL HULL RECORD BOOK 1861-1906  
See Sec. 1 preceding page

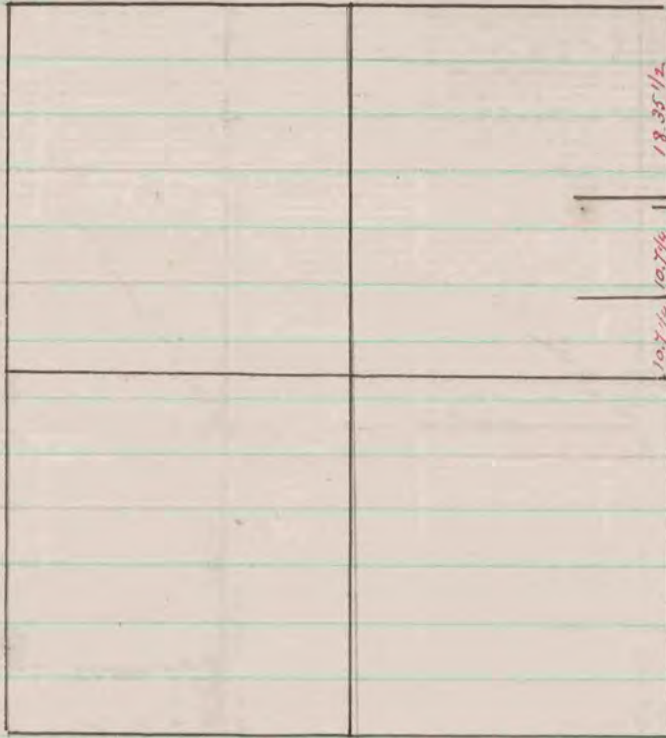

18.35 1/2  
19.25  
Set h. h. 16x12x12  
under 1.  
Set hand 19x11x7  
See Sec. 1 do.

Record & Plat of a survey made on Sec. 2 T. 3 N. R. 11. E. by S. D. Locke Co. Surveyor Center

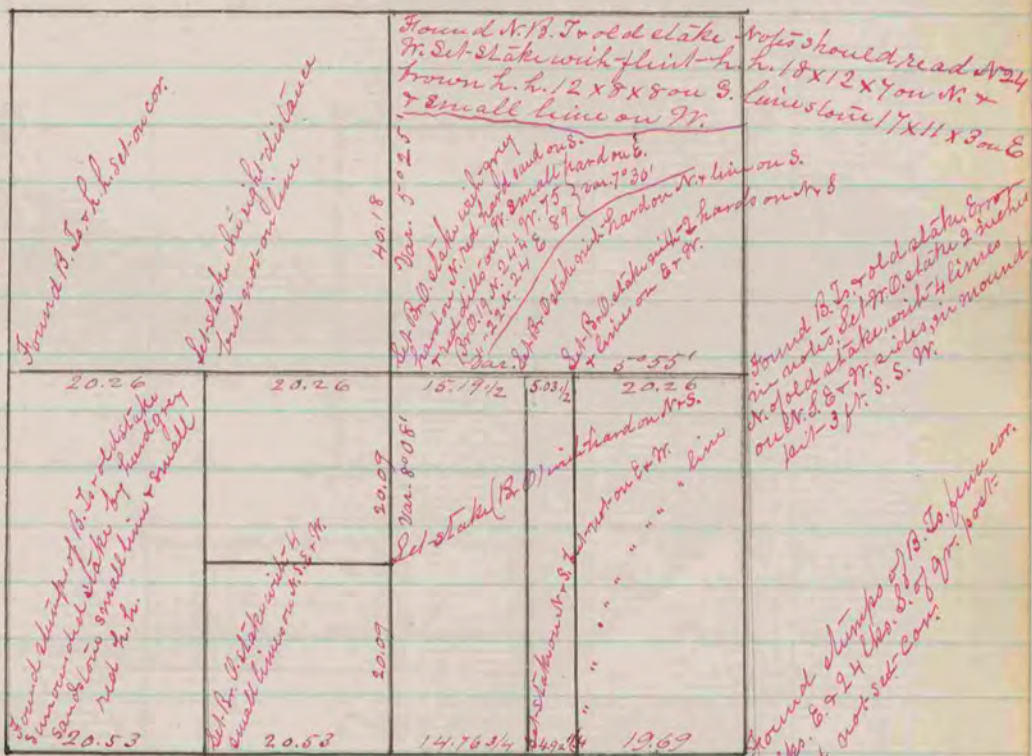

Plymouth

Record & Plat of a survey made on Sec. 12 T. 2 N. R. 11. E. July 15 & 16 1864 by S. D. Locke Co. Surveyor Plymouth

COUNTY SURVEYOR  
RECORD 1859-1906