


RECORDED IN THE
COUNTY SURVEYOR'S
OFFICE

Plymouth 247

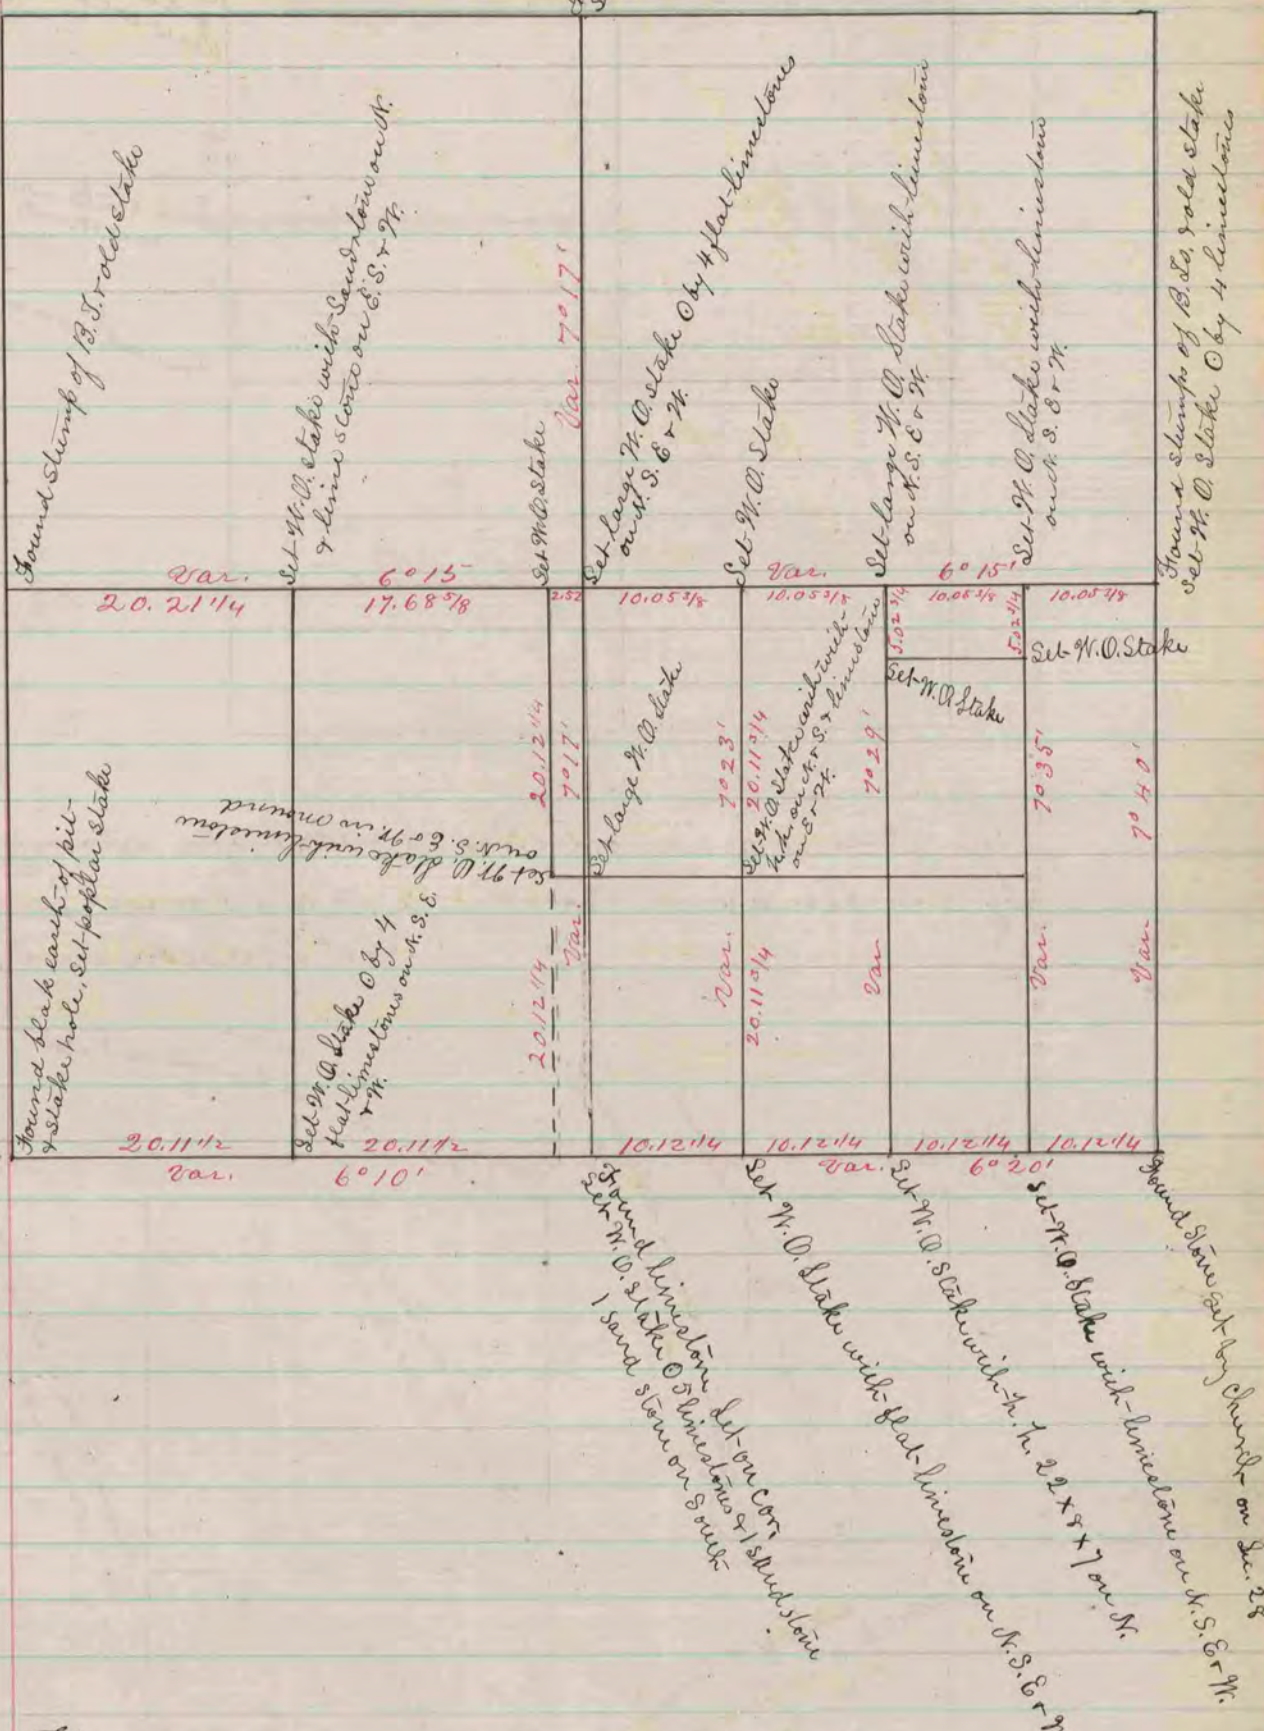

The above is a correct Record & Plat of a survey
 made by me May 15 & 16 1867. on Sec. 20 Plymouth
 S. H. Locke Co. Sur. Rocks Co.

COUNTY SURVEYOR
 RECORD 1859-1906