



Found E.B. J. Trilump
 M.B. J. T. old stake
 F.B. J. is 2.30 ch. in
 T 1.80
 Var. 20.12
 Let. h. 13' x 11' x 7' with 130
 D. Stake on N. in ground
 pit - 3 ft. S.
 6° 25'
 20.12
 Found old stake - let.
 h. 15' x 11' x 8' on N.

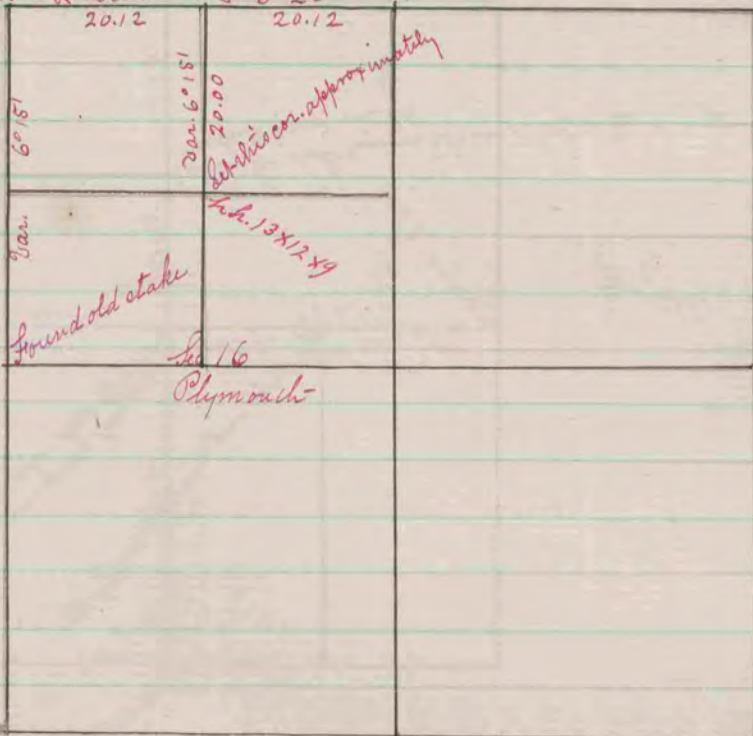

RECORDED
 COUNTY RECORDS

Record & Plat of a survey made on Sec. 16 Plymouth - March 31 1865 by S. D. Locke Co. Surveyors

Found old stake set for plan
 stake with h. in ground
 on N. a line stake 20 x 6 x 4 on S.
 & smaller one on N. in ground

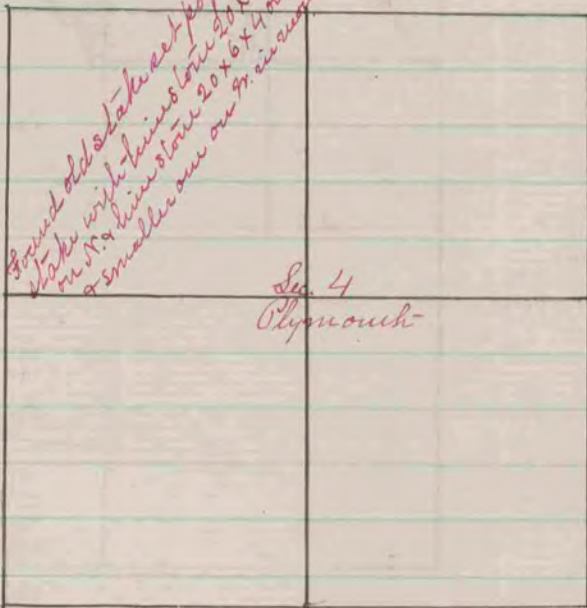

COUNTY SURVEYOR
 RECORD 1859-1906

Plymouth

Record & Plat of a survey made on Sec. 4 Plymouth March 31 1865 by S. D. Locke Co. Surveyors