


The above is a correct Record & Plat of a Survey made by me March 23, 1868, on Sec. 7 ~~Rock~~ Rock
S. D. Locke, County Surveyor

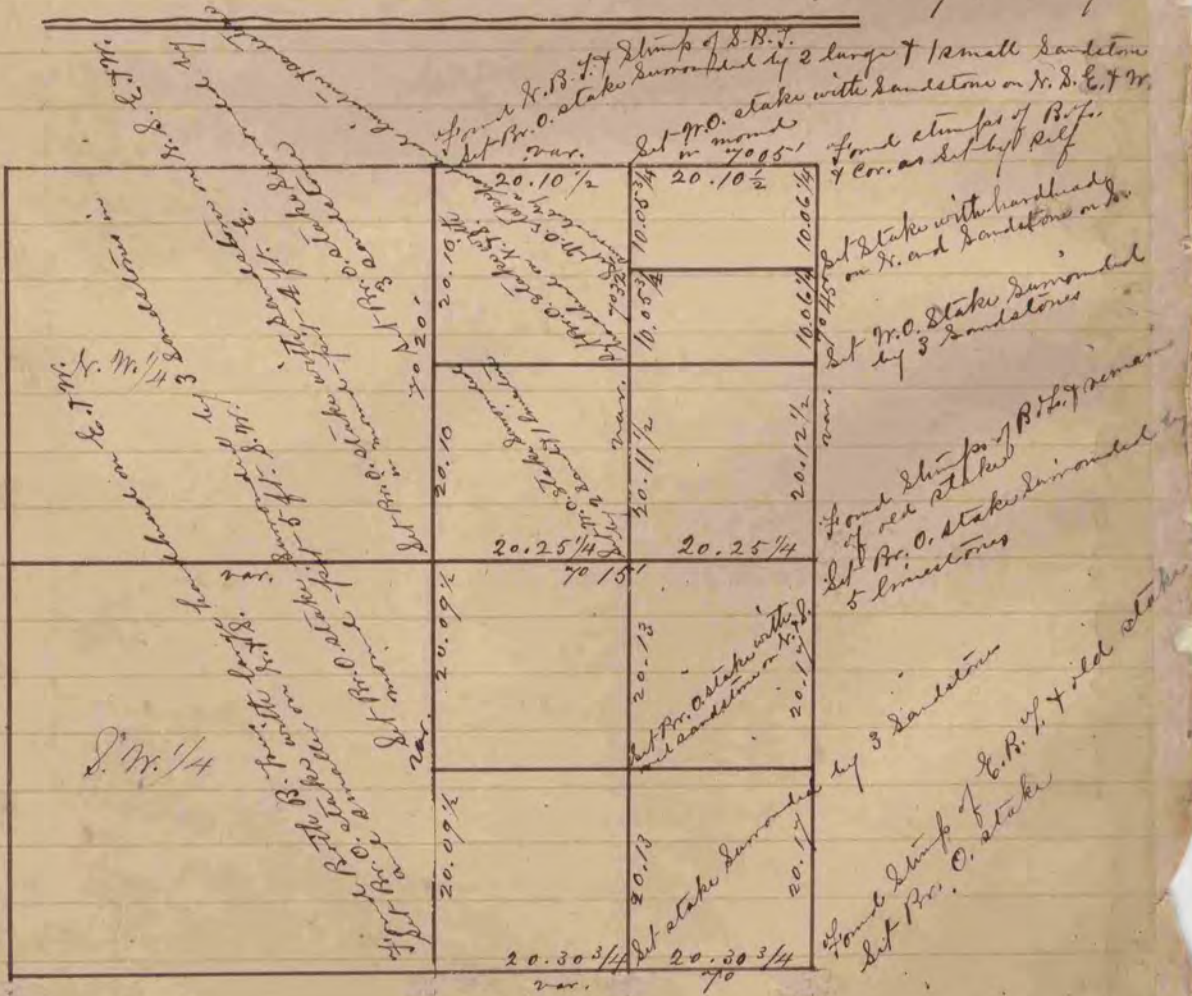

The above is a correct Record & Plat of a Survey made by me April 8 79, 1868 on Sec. 16, Magnolia - S. D. Locke, Co. Surveyor